

CARD MUST BE TYPED

State of Kansas

CARD MUST BE SIGNED

NOTICE OF INTENTION TO DRILL

(see rules on reverse side)

Expected Spud Date... 8 month 8 day 1988 year

API Number 15- 077-21,178-00-00 ✓

OPERATOR: License # 5399

NE. NE. NW. Sec. 6 Twp. 31 S, Rg. 7 X East X West

Name American Energies Corporation

4,950 Ft. from South Line of Section

Address 155 N. Market, Suite 710

2,970 Ft. from East Line of Section

City/State/Zip Wichita, KS 67202

(Note: Locate well on Section Plat on reverse side)

Contact Person Alan L. DeGood

Nearest lease or unit boundary line 330 feet

Phone 316-263-5785

County Harper

CONTRACTOR: License # 5418

Lease Name Lechner Well # A.#1

Name Allen Drilling Company

Ground surface elevation 1,635 est. feet MSL

City/State Great Bend, KS

Domestic well within 330 feet: yes X no

Well Drilled For: Well Class: Type Equipment:

Municipal well within one mile: yes X no

X Oil Storage Infield X Mud Rotary

Depth to bottom of fresh water 125 140

Gas Inj Pool Ext. Air Rotary

Depth to bottom of usable water 125 130

OWWO Expl X Wildcat Cable

Surface pipe by Alternate: 1 X 2

If OWWO: old well info as follows:

Surface pipe planned to be set 250

Operator

Conductor pipe required n/a

Well Name

Projected Total Depth 4,800 feet

Comp Date Old Total Depth.....

Formation Arbuckle

I certify that well will comply with K.S.A. 55-101, et seq., plus eventually plugging hole to KCC specifications.

Date 8-4-88 Signature of Operator or Agent V.K. Downey

Title President

For KCC Use:

Conductor Pipe Required feet; Minimum Surface Pipe Required 200' feet per Alt. 1 X

This Authorization Expires 8-4-89 Approved By EKM 8-4-88


EFFECTIVE DATE: 8-9-88

Must be filed with the K.C.C. five (5) days prior to commencing well
This card void if drilling not started within six (6) months of date received by K.C.C.

Important procedures to follow:

1. Notify District office before setting surface casing.
2. Set surface casing by circulating cement to the top.
3. File completion forms ACO-1 with K.C.C. within 120 days of well spud date, following instructions on ACO-1, side 1, and including copies of wireline logs.
4. Notify District office 48 hours prior to old well workover or re-entry.
5. Prior to filing Intent, prepare a proposed plugging plan in case well is D & A, then obtain approval of plan when calling district office prior to setting surface pipe.
6. Submit plugging report (CP-4) to K.C.C. after plugging is completed.
7. Obtain an approved injection docket number before disposing of salt water.
8. Notify K.C.C. within 10 days when injection commences or terminates.

**A Regular Section of Land
1 Mile = 5,280 Ft.**

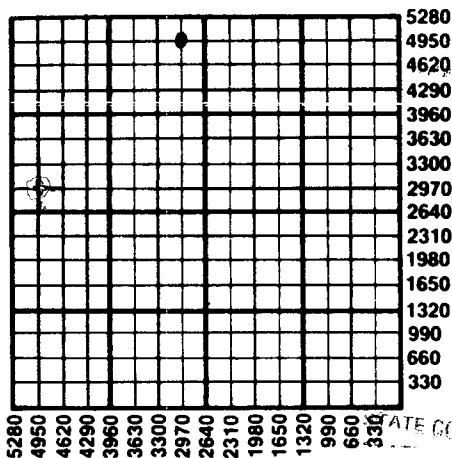

RECEIVED
STATE CORPORATION COMMISSION
AUG 4 1988
08-04-1988
CONSERVATION DIVISION
Wichita, Kansas

If an alternate 2 completion, cement in the production pipe from below any usable water to surface within 120 days of spud date.

State Corporation Commission of Kansas
Conservation Division
200 Colorado Derby Building
Wichita, Kansas 67202-1212
(316) 263-3238