

CARD MUST BE TYPED

State of Kansas
NOTICE OF INTENTION TO DRILL
(see rules on reverse side)

CARD MUST BE SIGNED

Starting Date: July 18, 1984
month day year

API Number 15- 135-22, 622-0000

OPERATOR: License # 5104
Name BLUE GOOSE DRILLING CO., INC.
Address P.O. Box 1413
City/State/Zip Great Bend, KS 67530
Contact Person Martin E. Miller
Phone 316 792-5633

C E/2 SE SW Sec 6 Twp 16 S, Rge 26
(location) East West
660 Ft North from Southeast Corner of Section
2970 Ft West from Southeast Corner of Section
(Note: Locate well on Section Plat on reverse side)

CONTRACTOR: License # 5104
Name Company tools
City/State

Nearest lease or unit boundary line 660 feet.
County Ness
Lease Name Carlson Well# 2
Domestic well within 330 feet: yes no
Municipal well within one mile: yes no

Well Drilled For: Well Class: Type Equipment:
 Oil Swd Infield Mud Rotary
 Gas Inj Pool Ext. Air Rotary
 OWWO Expl Wildcat Cable

Depth to Bottom of fresh water feet
Lowest usable water formation Dakota feet
Depth to Bottom of usable water 950 feet
Surface pipe by Alternate: 1 2
Surface pipe to be set 350 feet
Conductor pipe if any required feet
Ground surface elevation feet MSL
This Authorization Expires 11/13/85
Approved By 7/13/84 KC

If OWWO: old well info as follows:
Operator
Well Name
Comp Date Old Total Depth
Projected Total Depth 4600 feet
Projected Formation at TD Miss.
Expected Producing Formations Miss.

I certify that we will comply with K.S.A. 55-101, et seq., plus eventually plugging hole to K.C.C. specifications.

Date 7/12/84 Signature of Operator or Agent Martin E. Miller Title CONTRACT REPRESENTATIVE


MHC/KOHE 7-13-84
Form C-1 4/84

Must be filed with the K.C.C. five (5) days prior to commencing well
This card void if drilling not started within six (6) months of date received by K.C.C.

RECEIVED
STATE CORPORATION COMMISSION
7-13-84
JUL 13 1984

Important procedures to follow:

A Regular Section of Land
1 Mile = 5,280 Ft.

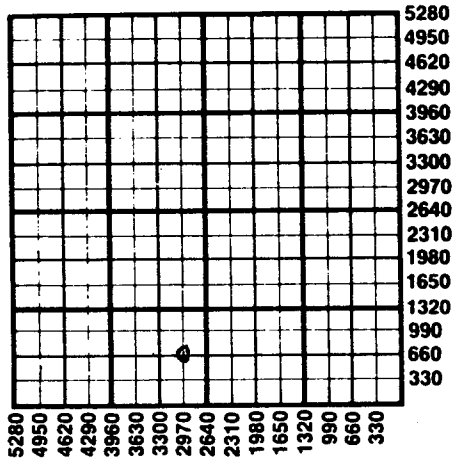

1. Notify District office before setting surface casing CONSERVATION DIVISION
Wichita, Kansas
2. Set surface casing by circulating cement to the top.
3. File completion forms ACO-1 with K.C.C. within 90 days of well completion, following instructions on ACO-1, side 1, and including copies of wireline logs.
4. Notify District office 48 hours prior to old well workover or re-entry.
5. Prior to plugging, prepare a plugging plan, then obtain agreement from the appropriate district office for an approved plugging plan.
6. Submit plugging report (CP-4) to K.C.C. after plugging is completed.
7. Obtain an approved injection docket number before disposing of salt water.
8. Notify K.C.C. within 10 days when injection commences or terminates.
9. If an alternate 2 completion, cement in the production pipe from below any usable water to surface within 120 days of spud date.

State Corporation Commission of Kansas
Conservation Division
200 Colorado Derby Building
Wichita, Kansas 67202
(316) 263-3238