

CARD MUST BE TYPED

State of Kansas

CARD MUST BE SIGNED ✓

NOTICE OF INTENTION TO DRILL

(see rules on reverse side)

Starting Date July 10, 1987
month day year

API Number 15- 135-23,137-0000

OPERATOR: License # 7200

NE SW SW Sec. 13 Twp. 16 S, Rg. 26 X East
990 West
4290 Ft. from South Line of Section
Ft. from East Line of Section

Name Scott T. Lutz

Address ... P.O. Drawer D

City/State/Zip ... Shell Knob, Mo. 65747

Contact Person. H.L. Maddox Scott T. Lutz ..

Phone 316-653-4178 417-858-6628

(Note: Locate well on Section Plat on reverse side)

Nearest lease or unit boundary line 330 feet

County Ness

CONTRACTOR: License # 5302

Lease Name. Evel Well # 1

Name Red Tiger Drilling

City/State Wichita, Kansas

Ground surface elevation NA feet MSL

Domestic well within 330 feet: _____yes X no

Municipal well within one mile: _____yes X no

Well Drilled For: Well Class: Type Equipment:

Depth to bottom of fresh water 80

Depth to bottom of usable water 1175

Surface pipe by Alternate: 1 _____ 2 X

Surface pipe planned to be set 300

Conductor pipe required None

Projected Total Depth 4600 feet

Formation Mississippi

If OWWO: old well info as follows:

Operator

Well Name

Comp Date Old Total Depth

I certify that well will comply with K.S.A. 55-101, et seq., plus eventually plugging hole to KCC specifications.

Date June 23, 87 Signature of Operator or Agent Title Owner Operator

For KCC Use:

Conductor Pipe Required feet; Minimum Surface Pipe Required 200 feet per Alt. X 2


This Authorization Expires ... 12-28-87 Approved By [Signature] 6-28-87

Must be filed with the K.C.C. five (5) days prior to commencing well
This card void if drilling not started within six (6) months of date received by K.C.C.

Important procedures to follow:

1. Notify District office before setting surface casing.
2. Set surface casing by circulating cement to the top.
3. File completion forms ACO-1 with K.C.C. within 90 days of well completion, following instructions on ACO-1, side 1, and including copies of wireline logs.
4. Notify District office 48 hours prior to old well workover or re-entry.
5. Prior to filing Intent, prepare a proposed plugging plan in case well is D & A, then obtain approval of plan when calling district office prior to setting surface pipe.
6. Submit plugging report (CP-4) to K.C.C. after plugging is completed.
7. Obtain an approved injection docket number before disposing of salt water.
8. Notify K.C.C. within 10 days when injection commences or terminates.
9. If an alternate 2 completion, cement in the production pipe from below any usable water to surface within 120 days of spud date.

A Regular Section of Land 1 Mile = 5,280 Ft.

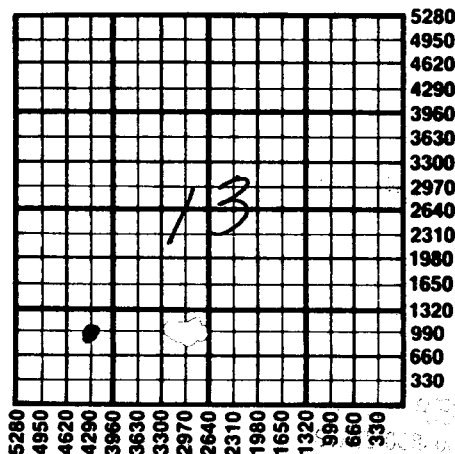

JUN 25 1987
6-25-87
CONSERVATION DIVISION
Wichita, Kansas

State Corporation Commission of Kansas
Conservation Division
200 Colorado Derby Building
Wichita, Kansas 67202
(316) 263-3238