

CARD MUST BE TYPED

State of Kansas

CARD MUST BE SIGNED

NOTICE OF INTENTION TO DRILL

(see rules on reverse side)

✓
O

Starting Date July 10 1987
month day year

API Number 15- 135-23, 136-0000

OPERATOR: License # ... KCC # 4689
Name Thomas C. Lutz
Address P O Drawer AR
City/State/Zip Shell Knob, Mo 65747
Contact Person H. L. Maddox Tom Lutz
Phone 316-653-4178 417-858-3792

C.S./2.SW NW/4 Sec. 13.. Twp. 16.. S, Rg. 26.... X West
..... 2970' Ft. from South Line of Section
..... 4620' Ft. from East Line of Section

(Note: Locate well on Section Plat on reverse side)

CONTRACTOR: License # 5302
Name Red Tiger Drilling
City/State Wichita, Kansas

Nearest lease or unit boundary line 330 feet
County Ness

Lease Name Evel C Well # #1
Ground surface elevation ... NA feet MSL

Well Drilled For: Well Class: Type Equipment:
X Oil SWD X Infield X Mud Rotary
Gas Inj Pool Ext Air Rotary
OWWO Expl Wildcat Cable

Domestic well within 330 feet: _____yes X no
Municipal well within one mile: _____yes X no

If OWWO: old well info as follows:

Depth to bottom of fresh water 80
Depth to bottom of usable water 1175
Surface pipe by Alternate: 1 2 X

Operator
Well Name
Comp Date Old Total Depth

Surface pipe planned to be set 300
Conductor pipe required None
Projected Total Depth 4600 feet

I certify that well will comply with K.S.A. 55-101, et seq., plus eventually plugging hole to KCC specifications.

Formation Mississippi

Date ... June 23, 1987 Signature of Operator or Agent

Title... Owner/Operator

For KCC Use:

Conductor Pipe Required feet; Minimum Surface Pipe Required 200 feet per Alt. X 2


This Authorization Expires 6-26-87 Approved By Pat 6-26-87

Must be filed with the K.C.C. five (5) days prior to commencing well
This card void if drilling not started within six (6) months of date received by K.C.C.

Important procedures to follow:

1. Notify District office before setting surface casing.
2. Set surface casing by circulating cement to the top.
3. File completion forms ACO-1 with K.C.C. within 90 days of well completion, following instructions on ACO-1, side 1, and including copies of wireline logs.
4. Notify District office 48 hours prior to old well workover or re-entry.
5. Prior to filing Intent, prepare a proposed plugging plan in case well is D & A, then obtain approval of plan when calling district office prior to setting surface pipe.
6. Submit plugging report (CP-4) to K.C.C. after plugging is completed.
7. Obtain an approved injection docket number before disposing of salt water.
8. Notify K.C.C. within 10 days when injection commences or terminates.
9. If an alternate 2 completion, cement in the production pipe from below any usable water to surface within 120 days of spud date.

A Regular Section of Land 1 Mile = 5,280 Ft.

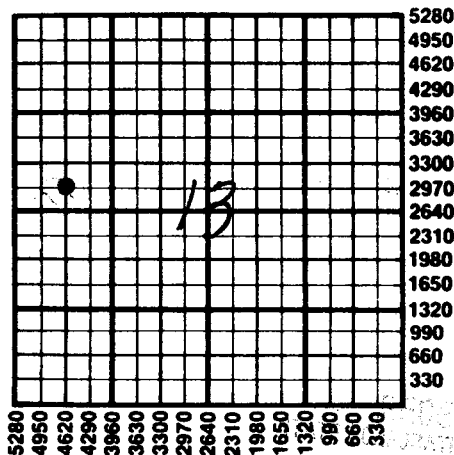

RECEIVED
JUN 25 1987
6-25-87
CONSERVATION DIVISION
Wichita, Kansas

State Corporation Commission of Kansas
Conservation Division
200 Colorado Derby Building
Wichita, Kansas 67202
(316) 263-3238