

CARD MUST BE TYPED

State of Kansas
NOTICE OF INTENTION TO DRILL
(see rules on reverse side)

CARD MUST BE SIGNED

Starting Date: December 1, 1984
month day year

API Number 15- 135-22,716-6000

OPERATOR: License # ... 5293

..SE. .NW ..NE Sec 18. . Twp 16. . S, Rge .26. East
(location) West

Name ... Helmerich & Payne, Inc.

Address ... P.O. Box 558

City/State/Zip ... Garden City, KS. 67846

Contact Person ... Millard L. Lindsay

Phone ... 316-276-3693

..... 4290 Ft North from Southeast Corner of Section

..... 1650 Ft West from Southeast Corner of Section

(Note: Locate well on Section Plat on reverse side)

CONTRACTOR: License #

Nearest lease or unit boundary line ... 330 feet.

County ... Ness

Name ... Unknown

Lease Name ... Norton Well# ... 2

City/State

Domestic well within 330 feet : yes no

Well Drilled For: Well Class: Type Equipment:

Municipal well within one mile : yes no

Oil Swd

Infield

Mud Rotary

Gas Inj

Pool Ext.

Air Rotary

OWWO Expl

Wildcat

Cable

If OWWO: old well info as follows:

Depth to Bottom of fresh water feet

Lowest usable water formation *Dakota* feet

Depth to Bottom of usable water *1000* feet

Surface pipe by Alternate : 1 ~~1~~ 2 ~~2~~

Surface pipe to be set 250' feet

Conductor pipe if any required feet

Ground surface elevation *N/A* feet MSL

This Authorization Expires *5-2-85*

Approved By *11-1-84* 

I certify that we will comply with K.S.A. 55-101, et seq., plus eventually plugging hole to K.C.C. specifications.


Date 10-31-84 Signature of Operator or Agent *Millard L. Lindsay*

Title District Prod. Manager

Must be filed with the K.C.C. five (5) days prior to commencing well
 This card void if drilling not started within six (6) months of date received by K.C.C.

Important procedures to follow :

A Regular Section of Land
1 Mile = 5,280 Ft.

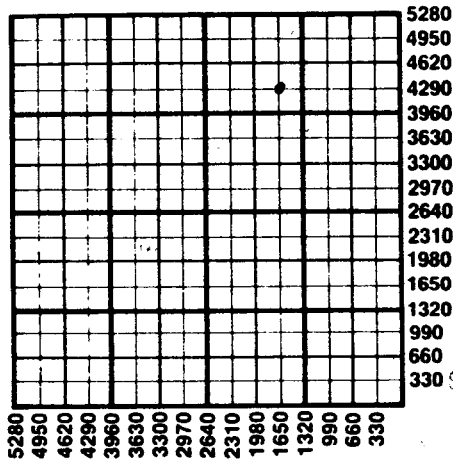

1. Notify District office before setting surface casing.
2. Set surface casing by circulating cement to the top.
3. File completion forms ACO-1 with K.C.C. within 90 days of well completion, following instructions on ACO-1, side 1, and including copies of wireline logs.
4. Notify District office 48 hours prior to old well workover or re-entry.
5. Prior to plugging, prepare a plugging plan, then obtain agreement from the appropriate district office for an approved plugging plan.
6. Submit plugging report (CP-4) to K.C.C. after plugging is completed.
7. Obtain an approved injection docket number before disposing of salt water.
8. Notify K.C.C. within 10 days when injection commences or terminates.
9. If an alternate 2 completion, cement in the production pipe from below any usable water to surface within 120 days of spud date.

NOV 01 1984
 11-1-84
 CONSERVATION DIVISION
 Wichita, Kansas

State Corporation Commission of Kansas
 Conservation Division
 200 Colorado Derby Building
 Wichita, Kansas 67202
 (316) 263-3238