

CARD MUST BE TYPED

NOTICE OF INTENTION TO DRILL

CARD MUST BE SIGNED

State of Kansas
(see rules on reverse side)

Starting Date: June 15, 1985
month day year

API Number 15- 135-22,840-0000

OPERATOR: License # 7388

RECEIVED
STATE COOPERATION COMMISSION
NE NW SE

Sec .17. Twp 16. S, Rge 26. East West

Name Wichita Industries, Inc.

Address 1801 California, Suite 4500

City/State/Zip Denver, CO 80202

Contact Person Doug Hammond

Phone 303-293-8167

JUN 10 1985
CONSERVATION DIVISION
Wichita, Kansas

2145..... Ft North from Southeast Corner of Section
2145..... Ft West from Southeast Corner of Section
(Note: Locate well on Section Plat on reverse side)

CONTRACTOR: License # 9087

Name R & C Drilling Co. Inc.

City/State Hays, KS

Nearest lease or unit boundary line 2145..... feet.
County Ness
Lease Name Carlson A Well# 1

Well Drilled For: Well Class: Type Equipment:

- Oil Swd Infield Mud Rotary
- Gas Inj Pool Ext. Air Rotary
- OWWO Expl Wildcat Cable

Domestic well within 330 feet: yes no
Municipal well within one mile: yes no

If OWWO: old well info as follows:

Operator

Well Name

Comp Date Old Total Depth

Projected Total Depth 4650 feet

Projected Formation at TD Mississippian

Expected Producing Formations Mississippian

Depth to Bottom of fresh water 800 feet

Lowest usable water formation Dakota

Depth to Bottom of usable water 800 950 feet

Surface pipe by Alternate: 1 2

Surface pipe to be set 350 feet

Conductor pipe if any required N/A feet

Ground surface elevation 2630 feet MSI.

This Authorization Expires 12-10-85

Approved By 6-10-85 *RC*

I certify that we will comply with K.S.A. 55-101, et seq., plus eventually plugging holes to K.C.C. specifications


Note: Production casing will have 2 stage collar set at 1900' and circulate cement to surface.

Date 6/7/85 Signature of Operator or Agent Douglas B. Hammond Title

MHC UDHE 6-10-85
Manager of Engineering surface.

**Must be filed with the K.C.C. five (5) days prior to commencing well
This card void if drilling not started within six (6) months of date received by K.C.C.**

**A Regular Section of Land
1 Mile = 5,280 Ft.**

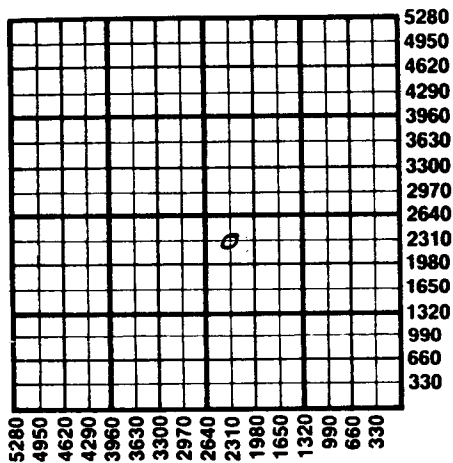

Important procedures to follow :

1. Notify District office before setting surface casing.
2. Set surface casing by circulating cement to the top.
3. File completion forms ACO-1 with K.C.C. within 90 days of well completion, following instructions on ACO-1, side 1, and including copies of wireline logs.
4. Notify District office 48 hours prior to old well workover or re-entry.
5. Prior to plugging, prepare a plugging plan, then obtain agreement from the appropriate district office for an approved plugging plan.
6. Submit plugging report (CP-4) to K.C.C. after plugging is completed.
7. Obtain an approved injection docket number before disposing of salt water.
8. Notify K.C.C. within 10 days when injection commences or terminates.
9. If an alternate 2 completion, cement in the production pipe from below any usable water to surface within 120 days of spud date.

**State Corporation Commission of Kansas
Conservation Division
200 Colorado Derby Building
Wichita, Kansas 67202
(316) 263-3238**