

STATE CORPORATION COMMISSION
CONSERVATION DIVISION AGENT REPORT

API Number 15-077-20,436-00-00

200 Colorado Derby Building
Wichita, KS 67202

Operator's Full Name Dickrell Drilling Company

Complete Address 205 Return Bldg Wichita Kansas 67202

Lease Name Shepard A (15-077-20,436) Well No. 1

Location SE-NW-SE Sec. 6 Twp. 31 Rge. 7 (East) (West)

County Harper Total Depth 4785'

Abandoned Oil Well Gas Well XX Input Well SWD Well D&A

Other well as hereinafter indicated

Plugging Contractor Colapete Corporation

Address Medicine Lodge, Kansas License No. 583

Operation Completed: Hour: 10³⁰ AM Day: 10 Month: 5 Year: 1982

Plugging Operations attended by Agent?: All XX Part None

The above well was plugged as follows:

4 1/2" set @ 4521' w/125 sf
P.B. to 4474' Top Perf 4390' - 4392'
SB to 4350' w/4 sf Pump 15 gal
6 hulls 10 gal. Release Plug +
displace w/ 150 sf Common Cement 370 cc
Allied SIP-300# Rev-3716 of 4 1/2"

Amount of Surface Casing: 212' of 8 5/8" sp w/ 180 sf

I hereby certify that the above plugging instructions were given as herein stated.

Signed: MTV Leslie
Conservation Division Agent

I hereby state that I was not present while the above well was being plugged, however, to the best of my knowledge and belief it was plugged as herein stated. A full account for my not being present is as follows:

Signed:
Conservation Division Agent

RECEIVED
STATE CORPORATION COMMISSION
MAY 17 1982
CONSERVATION DIVISION
Wichita Kansas

INVOICED
DATE 5-19-82
INV. NO. 203-W



15-077-20434-00-00

8931

209 SOUTH MAIN
MEDICINE LODGE, KANSAS 67104

DATE 5.5 1982

SOLD TO Pickwell Dely

DEL. TO Shubert # 1

DEL. BY	CUST. ORD. NO.
SALESMAN	ORD. BY

SALE	CASH	CREDIT				CREDIT	PAYMENT	MDSE. RETO.	OTHER	SALESMAN	ORD. BY
		REG.	30-60-90	RBA	OTHER						

PCS.	DESCRIPTION	FEET	TOTAL FEET	PRICE	AMOUNT	FOR OFFICE USE		
4	5K Portland Cement			585	2340			

340

70

TOTAL 2410

RECEIVED THE ABOVE IN GOOD CONDITION

REC'D BY for how Lumberland
THANK YOU - WE APPRECIATE YOUR BUSINESS!


DELIVERY RECEIPT

BAKER SERVICE TOOLS - TALLY PAD

New Completion Workover

15-077-20436-00-00

Oil Company _____ Well No. 1 Field Washboy Lease Shepherd
Company Man _____ Date Drilled July 1977 County Harper State Kansas

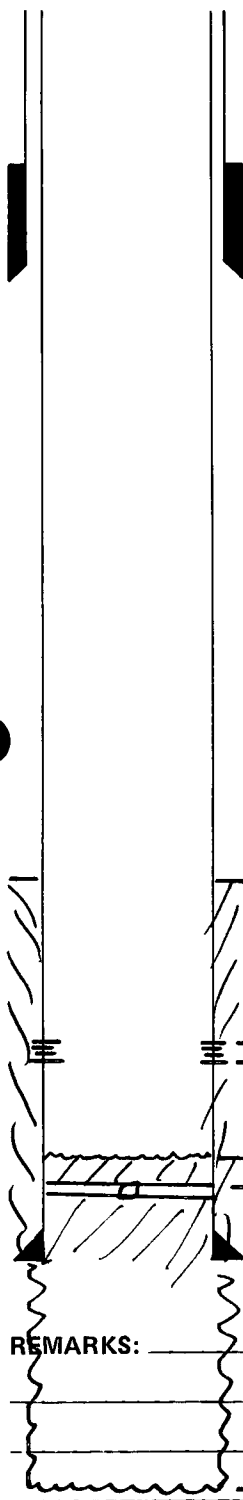

- 212 Base 8 5/8" Surface w/ 180 SX (Circ.)

- 3960 ESTIMATED Top of Cement

- 4390-4393 (Miss Perfs)

- 4474 PBD (Loggers)

- 4486 Float

- 4521 Base 4 1/2" 10.5# K-SS w/ 125 SX

REMARKS:

- 4785 RTD

RECEIVED
STATE CORPORATION COMMISSION

MAR 24 1977
CONSERVATION DIVISION
Wichita Kansas

Average ft. lgrd. this page

Date of Tally _____

No. Jts. on Location _____

Tbg. Sz. _____ Thd. _____ Wt. _____ Gr. _____

Csg. Sz. _____ Wt. _____ Gr. _____



A BAKER OIL TOOLS COMPANY