


STATE OF KANSAS  
STATE CORPORATION COMMISSION

WELL PLUGGING RECORD

Give All Information Completely  
Make Required Affidavit  
Mail or Deliver Report to  
Conservation Division  
State Corporation Comm.  
245 North Water  
Wichita, KS 67202

Harper County. Sec. 6 Twp. 31S Rge. 7W E/W  
Location as "NE/CNW 1/4 SW 1/4" or footage from lines  
C-SW-NE

Lease Owner Pickrell Drilling Company  
Lease Name Washbon Well No. B-1  
Office Address 205 Litwin Build, 110 N. Market, Wichita, Kansas  
Character of Well (Completed as Oil, Gas or Dry Hole)  
Gas

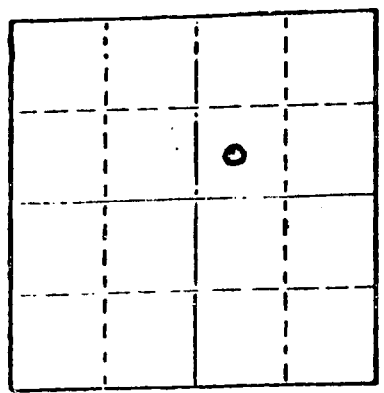

Locate well correctly on above  
Section Plot

Date Well completed 6-21 1975  
Application for plugging filed 6-24 1980  
Application for plugging approved 6-26 1980  
Plugging commenced 8-25 1980  
Plugging completed 8-30 1980

Reason for abandonment of well or producing formation  
Dry (depleted)  
If a producing well is abandoned, date of last production  
7-12 1980

Was permission obtained from the Conservation Division or  
its agents before plugging was commenced? Yes

Name of Conservation Agent who supervised plugging of this well Bill Owens  
Producing formation Mississippi Depth to top 4384 Bottom 4636 Total Depth of Well 4765  
Show depth and thickness of all water, oil and gas formations.

OIL, GAS OR WATER RECORDS

CASING RECORD

FORMATION	CONTENT	FROM	TO	SIZE	PUT IN	PULLED OUT
				8 5/8	219	None
				5 1/2	4764	3909

Describe in detail the manner in which the well was plugged, indicating where the mud fluid  
was placed and the method or methods used in introducing it into the hold. If cement or other  
plugs were used, state the character of same and depth placed, from \_\_\_\_\_ feet to  
\_\_\_\_\_ feet for each plug set.

Baker bridge plug at 4460  
Sand from 4460 to 4360  
5 sacks cement from 4360 - 4320

Ripped at 3908 - Pulled 5 1/2" 3908

Wood bridge at 360'  
Reek from 360' to 350'  
6 yards ready mix to surface

(If additional description is necessary, use BACK of this sheet)

Name of Plugging Contractor Clarke Corporation

STATE OF Kansas COUNTY OF Barber, ss.  
Elmo R. Mergenstern (employee of owner) or (owner or operator)  
of the above-described well, being first duly sworn on oath, says: That I have knowledge of  
the facts, statements, and matters herein contained and the log of the above-described well  
as filed and that the same are true and correct. So help me God.

(Signature) Elmo R. Mergenstern  
Medicine Lodge, Kansas  
(Address)

SUBSCRIBED AND SWORN TO before me this 4th day of September, 1980

Jessie Hamilton  
Notary Public.

My commission expires April 4, 1982.

NOTARY DRILLING LOG

COMPANY: PICKRELL DRILLING COMPANY  
 Litwin Bldg. Suite 205  
 110 N. Market  
 LOCATION: Wichita, Ks. 02  
 Washbon "B" #1  
 C SW NE 6-31S-7W  
 Wichita, Ks.  
 CONTRACTOR: PICKRELL DRILLING COMPANY  
 Wichita, Kansas

Rotary Drilling Commenced 5-17-75  
 Rotary Drilling Completed 5-29-75

CASING RECORD: 8 5/8" set at 219' with 175 sacks cement.  
 5 1/2" set at 4764

LOG

(Figures indicate bottom of formation — measurements from top of rotary bushing.)

Top soil Sand	100
Red Beds	225
Shale & Shells	940
Shale & Shells	1300
Shale w/Lime stks.	1530
Shale	1700
Lime & Shale	1885
Lime & Shale	2095
Lime & Shale	2395
Lime & Shale	2655
Lime & Shale	2890
Shale Sand Lime	3015
Lime & Shale	3220
Lime & Shale	3370
Shale & Lime	3465
Shale & Lime	3645
Shale & Lime	3780
Lime & Shale	3923
Lime	4015
Lime	4100
Lime	4205
Lime	4300
Lime	4385
Miss.-Lime	4395
Lime	4405
Lime	4415
Lime & Shale	4500
Lime & Shale	4600
Lime	4675
Lime & Shale	4735
Lime - RTD	4765

CONSERVATION COMMISSION  
 JUN 25 1980  
 CONSERVATION DIVISION  
 Wichita, Kansas  
 06-25-1980

The undersigned, C. W. Sebitts, Attorney-in-Fact for PICKRELL DRILLING COMPANY, hereby certifies in behalf of said Company, that the above is a true and correct log of the formation encountered in drilling the above well as reflected by the Daily Drilling Reports.

PICKRELL DRILLING COMPANY  
 By [Signature]  
 C. W. Sebitts Attorney-in-Fact

STATE OF KANSAS }  
 COUNTY OF SEDGWICK } ss.:

On this 6 day of November, 19 75, before me the undersigned, a Notary Public, in and for the County and State aforesaid, personally appeared C. W. Sebitts, to me known to be the identical person who subscribed the name of PICKRELL DRILLING COMPANY to the foregoing instrument as its Attorney-in-Fact and acknowledged to me that he executed the same as his free and voluntary act and deed, and as the free and voluntary act and deed of such company, for the uses and purposes therein set forth.

Given under my hand and seal of office the day and year last above written.

My commission expires:

STATE NOTARY PUBLIC	HELEN L. MARTIN
SEDGWICK COUNTY, KS.	My Appmt. Exp. Aug. 19, 1976

[Signature]  
 Helen L. Martin Notary Public