


STATE OF KANSAS
STATE CORPORATION COMMISSION

WELL PLUGGING RECORD

Give All Information Completely
Make Required Affidavit
Mail or Deliver Report to
Conservation Division
State Corporation Comm.
245 North Water
Wichita, KS 67202

Ness County. Sec. 6 Twp. 16S Rge. 26 EXW
Location as "NE/CNW $\frac{1}{4}$ SW $\frac{1}{4}$ " or footage from lines
SE NE SW

Lease Owner Kansas Oil Corporation
Lease Name Carlson Well No. 1
Office Address 400 N. Woodlawn, Suite 2, Wichita, Ks. 67208
Character of Well (Completed as Oil, Gas or Dry Hole) _____

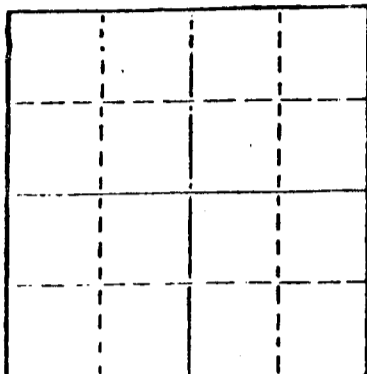

Locate well correctly on above
Section Plat

Date Well completed 7-26 1979
Application for plugging filed 7-26 1979
Application for plugging approved 7-26 1979
Plugging commenced 7-26 1979
Plugging completed 7-26 1979

Reason for abandonment of well or producing formation
no commercial quantity of oil or gas encountered
If a producing well is abandoned, date of last production
-- 19

Was permission obtained from the Conservation Division or
its agents before plugging was commenced? yes

Name of Conservation Agent who supervised plugging of this well Marion Schmidt
Producing formation _____ Depth to top _____ Bottom _____ Total Depth of Well 4610
Show depth and thickness of all water, oil and gas formations.

OIL, GAS OR WATER RECORDS

CASING RECORD

| FORMATION | CONTENT | FROM | TO | SIZE | PUT IN | PULLED OUT |
|--------------|---------|------|------|--------|--------|------------|
| surface hole | shale | surf | 354' | 8-5/8" | 346 | none |
| | | | | | | |
| | | | | | | |

Describe in detail the manner in which the well was plugged, indicating where the mud fluid was placed and the method or methods used in introducing it into the hold. If cement or other plugs were used, state the character of same and depth placed, from _____ feet to _____ feet for each plug set.

Fluid to 890', plug, 70 sx
Fluid to 395', plug, 20 sx
Fluid to 40', plug, 10 sx
Rat Hole 3 sx

RECEIVED
STATE CORPORATION COMMISSION

(If additional description is necessary, use BACK of this sheet)
Name of Plugging Contractor D N B DRILLING, INC. AUG - 3 1979
515 R. H. Garvey Building 8-3-79
Wichita, Kansas 67202

STATE OF Kansas COUNTY OF Sedgwick, ss.
Ella Priess (employee of owner) or (owner or operator)
of the above-described well, being first duly sworn on oath, says: That I have knowledge of the facts, statements, and matters herein contained and the log of the above-described well as filed and that the same are true and correct. So help me God.

(Signature) Ella Priess
515 R.H. Garvey Bldg., Wichita, Ks. 67202
(Address)

SUBSCRIBED AND SWORN TO before me this 31st day of July, 19 79

My commission expires April 30, 1983

Dorothy L. Schmidt
Dorothy L. Schmidt Notary Public.

DOROTHY L. SCHMIDT
STATE NOTARY PUBLIC
Sedgwick County, Kansas
My Appt. Exp. April 30, 1983

DRILLER'S LOG

15:135 21655 0000

KANSAS OIL CORPORATION
No. 1 Carlson
SE NE SW Sec 6-16S-26W
Ness Co., Ks.

Commenced: 7-17-79
Completed: 7-26-79

Surface Casing: 346' of 8-5/8"
cmtd w/225 sx common, 2% gel, 3% cc

FORMATION

DEPTH

| | |
|--------------|-----------------|
| Surface Hole | 0 - 354 |
| Shale | 354 - 1504 |
| Blaine | 1504 - 1511 |
| Shale & Lime | 1511 - 2250 |
| Lime & Shale | 2250 - 2950 |
| Shale & Lime | 2950 - 3134 |
| Shale | 3134 - 3156 |
| Shale & Lime | 3156 - 3255 |
| Lime & Shale | 3255 - 3960 |
| Lime | 3960 - 4610 RTD |

I do hereby certify that the foregoing statements are true and correct to the best of my knowledge and belief.

D N B DRILLING, INC.

Ella Priess
Ella Priess

STATE OF KANSAS: ss:

Subscribed and sworn to before me this 30th day of July, 1979.

Dorothy L. Schmidt
Dorothy L. Schmidt, Notary Public

DOROTHY L. SCHMIDT
STATE NOTARY PUBLIC
Sedgwick County, Kansas
My Appt. Exp. April 30, 1983

RECEIVED
STATE COMMISSION

AUG - 3 1979

CONSERVATION DIVISION
Wichita, Kansas