

STATE OF KANSAS
STATE CORPORATION COMMISSION


Form CP-4

Give All Information Completely
Make Required Affidavit
Mail or Deliver Report to:
Conservation Division
State Corporation Commission
212 No. Market
Wichita, Kansas 67202

WELL PLUGGING RECORD

Ness County, Sec. 6 Twp. 16S Rge. (E) 26 (W)

Location as "NE/CNW/SW" or footage from lines SE NE SE
Lease Owner Nadel and Gussman Oil Producers
Lease Name BASSINGER Well No. 1
Office Address First National Tower, 32nd Floor, Tulsa, Oklahoma 74103
Character of Well (completed as Oil, Gas or Dry Hole) Dry Hole
Date well completed August 11 1975
Application for plugging filed (verbal) August 11 1975
Application for plugging approved (verbal) August 11 1975
Plugging commenced August 11 1975
Plugging completed August 11 1975
Reason for abandonment of well or producing formation No producing quantities of oil or gas encountered.
If a producing well is abandoned, date of last production N/A 19__
Was permission obtained from the Conservation Division or its agents before plugging was commenced? Yes - verbally

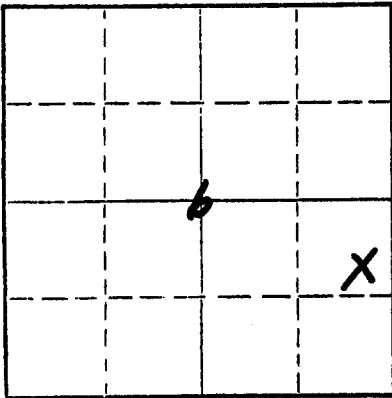

Locate well correctly on above Section Plat

Name of Conservation Agent who supervised plugging of this well Leo Massey
Producing formation _____ Depth to top _____ Bottom _____ Total Depth of Well 4552 Feet
Show depth and thickness of all water, oil and gas formations.

OIL, GAS OR WATER RECORDS

CASING RECORD

FORMATION	CONTENT	FROM	TO	SIZE	PUT IN	PULLED OUT
				8-5/8"	335'	None

Describe in detail the manner in which the well was plugged, indicating where the mud fluid was placed and the method or methods used in introducing it into the hole. If cement or other plugs were used, state the character of same and depth placed, from _____ feet to _____ feet for each plug set.

1st Plug Set @ 900' with 70 sx. 50/50 Posmix
2nd Plug Set @ 240' with 20 sx. " "
3rd Plug Set @ 40' with 10 sx. " "

RECEIVED
STATE CORPORATION COMMISSION

AUG 14 1975
8-14-75
CONSERVATION DIVISION
Wichita, Kansas

(If additional description is necessary, use BACK of this sheet)
Name of Plugging Contractor Abercrombie Drilling, Inc.
Address 801 Union Center, Wichita, Kansas 67202

STATE OF KANSAS, COUNTY OF SEDGWICK, ss.
Jack K. Wharton (employee of owner) or (owner) of the above-described well, being first duly sworn on oath, says: That I have knowledge of the facts, statements, and matters herein contained and the log of the above-described well as filed and that the same are true and correct. So help me God.

(Signature) Jack K. Wharton
801 Union Center, Wichita, Kansas 67202 (Address)

Subscribed and sworn to before me this 13th day of August, 1975



Nancy E. Haner
Notary Public.

CONTRACTOR'S WELL LOG

15-135-21082-0000

OPERATOR: Nadel and Gussman Oil Producers
 CONTRACTOR: Abercrombie Drilling, Inc. (Rig #11)
 WELL NAME: BASSINGER #1
 LOCATION: SE NE SE Section 6-16S-26W
 Ness County, Kansas
 GEOLOGIST: Tom Wesselowski
 SPUD DATE: August 2, 1975
 COMPLETION DATE: August 11, 1975

0	335	Clay & Shale
335	1150	Shale
1150	1225	Sand
1225	1625	Shale
1625	1812	Sand
1812	1936	Shale
1936	2064	Shale and shells
2064	2100	Anhydrite
2100	2350	Shale and shells
2350	2898	Shale and lime
2898	4005	Lime and shale
4005	4552	Lime
	4552	Rotary Total Depth

Drilled 335' of 12 1/4" surface hole, ran 8 jts. 8-5/8" surface casing, set @ 335'. Cemented with 200 sacks Common cement, 2% gel, 3% calcium chloride. Cement circulated. Plug was down @ 6:45 p.m., August 1, 1975.

Plugged and Abandoned: 1st Plug set @ 900' with 70 sacks 50/50 Posmix, 2nd Plug set @ 240' with 20 sacks 50/50 Posmix and 3rd Plug set @ 40' with 10 sacks 50/50 Posmix. Plug was down @ 11:00 p.m., August 11, 1975

STATE OF KANSAS)
) SS
 COUNTY OF SEDGWICK)

Jack K. Wharton, Geologist of Abercrombie Drilling, Inc., does hereby state that the above and foregoing is a true and correct copy of the log of the BASSINGER #1, SE NE SE Section 6-16S-26W, Ness County.


ABERCROMBIE DRILLING, INC.

Jack K. Wharton
 Jack K. Wharton, Geologist

Subscribed and sworn to before me, a Notary Public, in and for the aforesaid county and state as of this 13th day of August, 1975.

Nancy E. Haner
 Nancy E. Haner, Notary Public

My Commission Expires: April 8, 1978

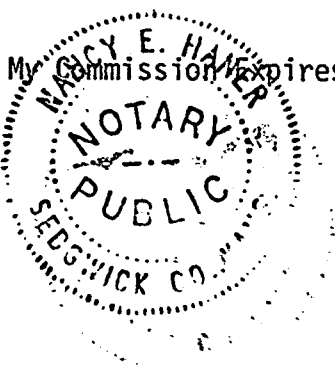

RECEIVED
 STATE CORPORATION COMMISSION

AUG 14 1975

CONSERVATION DIVISION
 Wichita, Kansas