

STATE OF KANSAS
STATE CORPORATION COMMISSION

Form CP-4

JCC


WELL PLUGGING RECORD

Give All Information Completely
Make Required Affidavit
Mail or Deliver Report to:
Conservation Division
State Corporation Commission
211 No. Broadway
Wichita, Kansas

Ness County. Sec. 16 Twp. 16S Rge. 26 (E) (W)

Location as "NE/CNW/SW" or footage from lines C NW NW
Lease Owner Tom Kat, Inc.
Lease Name Suiter Well No. 1
Office Address 1125 Wichita Plaza, Wichita, Kansas
Character of Well (completed as Oil, Gas or Dry Hole) Dry Hole
Date well completed 7-26-65 19__
Application for plugging filed 7-26-65 19__
Application for plugging approved 7-26-65 19__
Plugging commenced 7-26-65 19__
Plugging completed 7-26-65 19__
Reason for abandonment of well or producing formation Dry Hole

NORTH

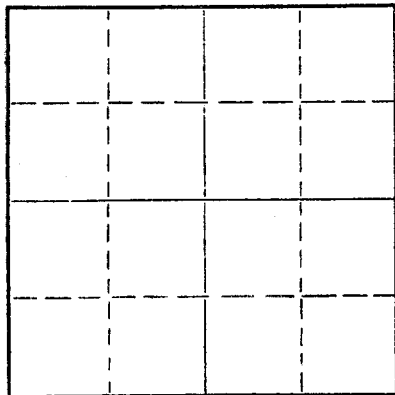

Locate well correctly on above
Section Plat

If a producing well is abandoned, date of last production _____ 19__
Was permission obtained from the Conservation Division or its agents before plugging was commenced? Yes

Name of Conservation Agent who supervised plugging of this well Gilbert Lieker
Producing formation _____ Depth to top _____ Bottom _____ Total Depth of Well _____ Feet

Show depth and thickness of all water, oil and gas formations.

OIL, GAS OR WATER RECORDS

CASING RECORD

FORMATION	CONTENT	FROM	TO	SIZE	PUT IN	PULLED OUT

Describe in detail the manner in which the well was plugged, indicating where the mud fluid was placed and the method or methods used in introducing it into the hole. If cement or other plugs were used, state the character of same and depth placed, from _____ feet to _____ feet for each plug set.

4630 - 540 - Heavy rotary mud
540 - HB plug, 20 sacks
540 - 240 - Heavy rotary mud
240 - HB plug, 20 sacks cement
240 - 40 - Heavy rotary mud
40 - GL - HB plug, 10 sacks cement

RECEIVED
STATE CORPORATION COMMISSION

AUG 4 - 1965
8-4-65
CONSERVATION DIVISION
Wichita, Kansas

(If additional description is necessary, use BACK of this sheet)

Name of Plugging Contractor Peel Brothers, Inc.
Address Box 359, Hoisington, Kansas

STATE OF Kansas, COUNTY OF Barton, ss.
Peel Brothers, Inc. (employee of owner) or (owner/operator) of the above-described well, being first duly sworn on oath, says: That I have knowledge of the facts, statements, and matters herein contained and the log of the above-described well as filed and that the same are true and correct. So help me God. PEEL BROTHERS, INC.
(Signature) Wendell C. Peel
Wendell C. Peel, President
(Address)

SUBSCRIBED AND SWORN TO before me this 27th day of July, 19 65

My commission expires 6-21-66

Ethel S. Williamson
Notary Public.

DRILLER'S LOG

15-135-30064-0000

Well Owner: Tom Kat, Inc.
Farm Name: Suiter No. 1
Date Started: 7-15-65
Date Completed: 7-26-65
Total Depth: 4630

0 NW NW
Section 16-16S-26E
Ness County, Kansas

Casings: 8-5/8" set at 248' cemented

Contractor: Peel Brothers, Inc.

Figures below show bottoms of formations:

Clay and Rock	0 - 100
Shale, Shell, Pyrite	1570
Sand	1630
Sand and Shale	1840
Shale and Red Bed	2074
Anhydrite	2107
Shale and Shells	2470
Lime, Shale and Chalk	3973
Lime	4510
Chert, Sand and Pyrite	4538
Lime and Chert	4630
Total Depth	4630

RECEIVED
STATE CORPORATION COMMISSION

AUG 23 1965

CONSERVATION DIVISION
Wichita, Kansas

This is to certify that the above information is to the best of our knowledge true and correct.

PEEL BROTHERS, INC.

Wendell C. Peel
President

SUBSCRIBED AND SWORN to before me this 2nd day of August, 1965.

Ethel S. Williamson
Notary Public

My commission expires 6-21-66

DRILLER'S LOG

Well Owner: Tom Kat, Inc.
Farm Name: Suiter No. 1
Date Started: 7-15-65
Date Completed: 7-26-65
Total Depth: 4630

C NW NW
Section 16-16S-26W
Ness County, Kansas

Casing: 8-5/8" set at 248' cemented

Contractor: Peel Brothers, Inc.

Figures below show bottoms of formations:

Clay and Rock	0	-	100
Shale, Shell, Pyrite			1570
Sand			1630
Sand and Shale			1840
Shale and Red Bed			2074
Anhydrite			2107
Shale and Shells			2470
Lime, Shale and Chalk			3973
Lime			4510
Chert, Sand and Pyrite			4538
Lime and Chert			4630
Total Depth			4630

RECEIVED
STATE COMMISSION COLLECTION
AUG 4 - 1965
COMMISSION DIVISION

This is to certify that the above information is to the best of our knowledge true and correct.

PEEL BROTHERS, INC.

Wendell G. Peel
Wendell G. Peel
President

SUBSCRIBED AND SWORN to before me this 2nd day of August, 1965.

Ethel S. Williamson
Ethel S. Williamson
Notary Public

My commission expires 6-21-66