

STATE OF KANSAS
STATE CORPORATION COMMISSION
200 Colorado Derby Building
Wichita, Kansas 67202

RECEIVED

WELL PLUGGING RECORD
K.A.R.-82-3-117

WICHITA OFFICE

TYPE OR PRINT
NOTICE: Fill out completely
and return to Cons. Div.
office within 30 days.

API NUMBER 15-135-22,025-0000

LEASE NAME Martin

WELL NUMBER #1

SPOT LOCATION NE NE SE

SEC. 15 TWP. 16 RGE. 26 (X) or (W)

COUNTY Ness

Date Well Completed 5-15-81

Plugging Commenced 10-2-85

Plugging Completed 10-2-85

LEASE OPERATOR The Reach Group
ADDRESS 229 E. William, Suite 500, Wichita, Ks. 67202

PHONE # (316) 262 1515 OPERATORS LICENSE NO. 8572

Character of Well Oil
(Oil, Gas, D&A, SWD, Input, Water Supply Well)

Did you notify the KCC/KDHE Joint District Office prior to plugging this well? yes

Which KCC/KDHE Joint Office did you notify? Dodge City

Is ACO-1 filed? yes If not, is well log attached? _____

Producing formation Mississippian Depth to top 4505 bottom 4510 T.D. 4563

Show depth and thickness of all water, oil and gas formations.

OIL, GAS OR WATER RECORDS

CASING RECORD

Formation	Content	From	To	Size	Put in	Pulled out
Surface		0	329	8 5/8"	329	0"
Production	(Miss.-oil & water)	0	4563	4 1/2"	4563	2600"

Describe in detail the manner in which the well was plugged, indicating where the mud fluid was placed and the method or methods used in introducing it into the hole. If cement or other plugs were used state the character of same and depth placed, from feet to feet each set. Pump 2 sks. hulls & 20 sks. cement to 4250' pressured to 750 lbs.

Pump 3 sks. hulls - 15 sks. Gel - 50 sks. cement - 15 sks. gel - 1 sk hulls

Release plug and 175 sks. cement - 400 lbs. shut in pressure

(If additional description is necessary, use BACK of this form.)

Name of Plugging Contractor Midwest Casing Pulling Service License No. 6497
Address Box F, Sublette, Ks. 67877

STATE OF KANSAS COUNTY OF HASKELL, ss.

I, Edgar J. Eves

(operator) of above-described well, being first duly sworn on oath, says: That I have knowledge of the facts, statements, and matters herein contained and the log of the above-described well as filed that the same are true and correct, so help me God.

STATE CORPORATION COMMISSION

(Signature) Edgar J. Eves

(Address) Box F, Sublette, Ks. 67877

NOV 1 1985
11-1-85
CONSERVATION DIVISION
Wichita, Kansas

SUBSCRIBED AND SWORN TO before me this 18 day of Oct., 1985

My Commission expires: 12-6-88

Sondra L. Eves
Notary Public



SONDRA L. EVES
Haskell County, Ks.
My Appt. Exp. 12-6-88

KANSAS

WELL COMPLETION REPORT AND DRILLER'S LOG

API No. 15 — 135 — 22,025-0000
County Number

S. 15 T. 16S R. 26 E W

Loc. NE NE SE

County Ness

Operator
Reach Petroleum Corporation

Address
3751 East Douglas, Wichita, KS 67218


Well No. #1 Lease Name Martin

Footage Location
2310 feet from (N) (S) line 330 feet from (E) (W) line

Principal Contractor Reach Drilling Geologist Chuck "Dusty" Rhodes

Spud Date 5-5-81 Date Completed 5-15-81 Total Depth 4563' P.B.T.D. 4533'

Directional Deviation None Oil and/or Gas Purchaser Inland Crude

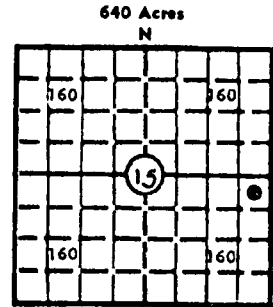

Elev.: Gr. 2564'

DF 2567' KB 2572'

CASING RECORD

Report of all strings set — surface, intermediate, production, etc.

Purpose of string	Size hole drilled	Size casing set (in O.D.)	Weight lbs/ft.	Setting depth	Type cement	Sacks	Type and percent additives
Surface		-5/8"		329'	common	200	2% gel, 3% CaCl
Production		4-1/2"		4566'	60-40 posmix	300	10% salt, 2% gel

LINER RECORD

PERFORATION RECORD

Top, ft.	Bottom, ft.	Sacks cement	Shots per ft.	Size & type	Depth interval
			2		4505-10'

TUBING RECORD

Size	Setting depth	Packer set at

ACID, FRACTURE, SHOT, CEMENT SQUEEZE RECORD

Amount and kind of material used	Depth interval treated
Production is natural without treatment.	4505-10'

INITIAL PRODUCTION

Date of first production 8-19-81	Producing method (flowing, pumping, gas lift, etc.) Pumping	CONSERVATION DIVISION Wichita, Kansas			
RATE OF PRODUCTION PER 24 HOURS	Oil 18 bbls.	Gas N/A MCF	Water 130 bbls.	Gas-oil ratio N/A	CFPB
Disposition of gas (vented, used on lease or sold) N/A	Producing interval(s) 4505-10'				

INSTRUCTIONS: As provided in KCC Rule 82-2-125, within 90 days after completion of a well, one completed copy of this Drillers Log shall be transmitted to the State Geological Survey of Kansas, 4150 Monroe Street, Wichita, Kansas 67209. Copies of this form are available from the Conservation Division, State Corporation Commission, 245 No. Water, Wichita, Kansas 67202. Phone AC 316-522-2206. If confidential custody is desired, please note Rule 82-2-125. Drillers Logs will be on an open file in the Oil and Gas Division, State Geological Survey of Kansas, Lawrence, Kansas 66044.