


STATE OF KANSAS  
STATE CORPORATION COMMISSION

Give All Information Completely  
Make Required Affidavit  
Mail or Deliver Report to:  
Conservation Division  
State Corporation Commission  
P. O. Box 17027  
Wichita, Kansas 67217  
NORTH

WELL PLUGGING RECORD

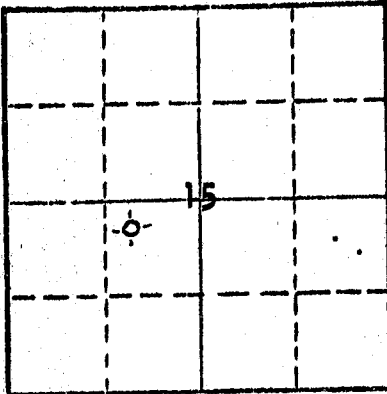

Locate well correctly on above Section Plat

NESS County, Sec. 15 Twp. 16S Rge. (E) 26W(W)  
Location no "NE/CNW/SE/SW" or footage from lines NW NE SW  
Lease Owner DANE G HANSEN TRUST  
Lessee Name HOLMES Well No. A #1  
Office Address LOGAN, KANSAS 67663  
Character of Well (completed as Oil, Gas or Dry Hole) DRY HOLE  
Date well completed JUNE 17 1974  
Application for plugging filed JUNE 17 1974  
Application for plugging approved JUNE 17 1974  
Plugging commenced JUNE 17 1974  
Plugging completed JUNE 17 1974  
Reason for abandonment of well or producing formation TOO LOW STRUCTURALLY  
If a producing well is abandoned, date of last production 19

Name of Conservation Agent who supervised plugging of this well LEO F MASSEY, HAYS, KANSAS  
Producing formation \_\_\_\_\_ Depth to top \_\_\_\_\_ Bottom \_\_\_\_\_ Total Depth of Well 4564 Feet  
Show depth and thickness of all water, oil and gas formations.

OIL, GAS OR WATER RECORDS

CASING RECORD

FORMATION	CONTENT	FROM	TO	SIZE	PUT IN	PULLED OUT
				8 5/8"	200.91'	NONE

Describe in detail the manner in which the well was plugged, indicating where the mud fluid was placed and the method or methods used in introducing it into the hole. If cement or other plugs were used, state the character of same and depth placed, from \_\_\_\_\_ feet to \_\_\_\_\_ feet for each plug set.

FILLED HOLE WITH HEAVY MUD TO 800', SET PLUG. PUT IN 70 SACKS CEMENT. FILLED WITH HEAVY MUD TO 185', SET PLUG. PUT IN 20 SACKS CEMENT, FILLED WITH HEAVY MUD TO 40'. SET PLUG. FILLED TO TOP WITH 1 SACK HULLS, 10 SACKS 50-50 CEMENT / 6& GEL.

RECEIVED  
STATE CORPORATION COMMISSION

JUN 27 1974

CONSERVATION DIVISION  
Wichita, Kansas

6-27-74

(If additional description is necessary, use BACK of this sheet)  
Name of Plugging Contractor C-G DRILLING CO.  
Address 1107 UNION NATIONAL BUILDING, WICHITA, KANSAS 67202

STATE OF KANSAS, COUNTY OF SEDGWICK ss.  
G. F. Galloway (employee of owner) or (owner or operator) of the above-described well, being first duly sworn on oath, says: That I have knowledge of the facts, statements, and matters herein contained and the log of the above-described well as filed and that the same are true and correct. So help me God.

(Signature) G. F. Galloway  
1107 Union National Building  
Wichita, Kansas 67202  
June 1974



Sworn to before me this 17th day of June, 1974  
December 7, 1975

Phyllis Buchanan  
Notary Public.

**KANSAS DRILLERS LOG**

S. 15 T. 16S R. 26W<sup>E</sup><sub>W</sub>

Loc. NW NE SW

County NESS

API No. 15 — 135 — 20877-0000  
County Number

Operator  
**DANE G HANSEN TRUST**

Address  
**LOGAN, KANSAS 67646**


Well No. "A" #1 Lease Name HOLMES

Footage Location N  
330 feet from XXX line 660 feet from (E)(W) line

Principal Contractor C-G DRILLING CO. Geologist JERRY JESPERSEN

Spud Date JUNE 7, 1974 Total Depth 4564 P.B.T.D.

Date Completed JUNE 17, 1974 Oil Purchaser

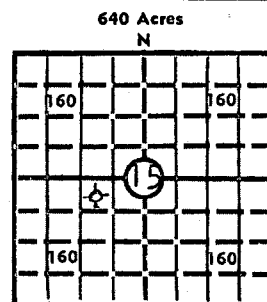

Elev.: Gr. \_\_\_\_\_

DF \_\_\_\_\_ KB 2603

**CASING RECORD**

Report of all strings set — surface, intermediate, production, etc.

Purpose of string	Size hole drilled	Size casing set (in O.D.)	Weight lbs/ft.	Setting depth	Type cement	Sacks	Type and percent additives
Surface	12 1/4"	8 5/8"	20#	200.91	Common	160	2% Gel 3% Ca Cl

**LINER RECORD**

**PERFORATION RECORD**

Top, ft.	Bottom, ft.	Sacks cement	Shots per ft.	Size & type	Depth interval

**TUBING RECORD**

Size	Setting depth	Packer set at

**ACID, FRACTURE, SHOT, CEMENT SQUEEZE RECORD**

Amount and kind of material used	Depth interval treated

**RECEIVED**  
 STATE CORPORATION COMMISSION

**JUN 27 1974**

**CONSERVATION DIVISION**  
 Wichita, Kansas

**INITIAL PRODUCTION**

Date of first production \_\_\_\_\_ Producing method (flowing, pumping, gas lift, etc.) \_\_\_\_\_

RATE OF PRODUCTION PER 24 HOURS	Oil	Gas	Water	Gas-oil ratio

Disposition of gas (vented, used on lease or sold) \_\_\_\_\_ Producing interval(s) \_\_\_\_\_

**INSTRUCTIONS:** As provided in KCC Rule 82-2-125, within 90 days after completion of a well, one completed copy of this Drillers Log shall be transmitted to the State Geological Survey of Kansas, 4150 Monroe Street, Wichita, Kansas 67209. Copies of this form are available from the Conservation Division, State Corporation Commission, 3830 So. Meridian (P.O. Box 17027), Wichita, Kansas 66217. Phone AC 316-522-2206. If confidential custody is desired, please note Rule 82-2-125. Drillers Logs will be on open file in the Oil and Gas Division, State Geological Survey of Kansas, Lawrence, Kansas 66044.

DESIGNATE TYPE OF COMP.: OIL, GAS,  
 DRY HOLE, SWDW, ETC.:  
 DRY HOLE

Operator  
 C-G DRILLING CO.

Well No.  
 "A" 1

Lease Name  
 HOLMES

s 15 T16S R26W<sup>E</sup><sub>W</sub>

**WELL LOG**

Show all important zones of porosity and contents thereof; cored intervals, and all drill-stem tests, including depth interval tested, cushion used, time tool open, flowing and shut-in pressures, and recoveries.

SHOW GEOLOGICAL MARKERS, LOGS RUN,  
 OR OTHER DESCRIPTIVE INFORMATION.

FORMATION DESCRIPTION, CONTENTS, ETC.	TOP	BOTTOM	NAME	DEPTH
SAND & SHALE	0	1215		
SHALE	1215	1540		
SAND	1540	1765		
SHALE	1765	1910		
RED BED & SHALE	1910	2029		
ANHYDRITE	2029	2074		
SHALE & SHELLS	2074	2390		
SHALE & LIME	2390	3955		
LIME	3955	4573		
RTD		4573		
LOG RUN				

USE ADDITIONAL SHEETS, IF NECESSARY, TO COMPLETE WELL RECORD.

Date Received

*Phyllis Buchanan*  
 Phyllis Buchanan Signature Office Mgr.

Title

June 19, 1974

Date