


STATE CORPORATION COMMISSION

WELL PLUGGING RECORD 15135-20783-6000

Give All Information Completely
Make Required Affidavit
Mail or Deliver Report to:
Conservation Division
State Corporation Commission
P. O. Box 17027
Wichita, Kansas 67217
NORTH

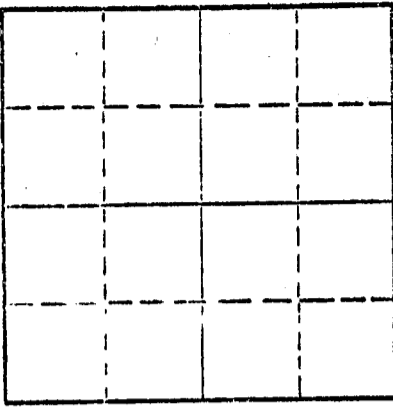

Locate well correctly on above Section Plat

Ness County, Sec. 11 Twp. 16S Rge. (E) 26 (W)
Location as 'NE/CNW%SW%' or footage from lines NE SW SE
Lease Owner Okmar Oil Company
Lease Name Ford Well No. 1
Office Address 1130 Wichita Plaza, Wichita, Kansas 67202
Character of Well (completed as Oil, Gas or Dry Hole) Dry Hole
Date well completed September 18 19 73
Application for plugging filed September 18 19 73
Application for plugging approved September 18 19 73
Plugging commenced September 18 19 73
Plugging completed September 18 19 73
Reason for abandonment of well or producing formation Dry Hole

If a producing well is abandoned, date of last production 19
Was permission obtained from the Conservation Division or its agents before plugging was commenced? Yes

Name of Conservation Agent who supervised plugging of this well Leo Massey, Hays, Kansas
Producing formation Depth to top Bottom Total Depth of Well 4550 Feet
Show depth and thickness of all water, oil and gas formations.

OIL, GAS OR WATER RECORDS

CASING RECORD

Table with 7 columns: FORMATION, CONTENT, FROM, TO, SIZE, PUT IN, PULLED OUT. Row 1: 8-5/8", 0, 370.52'

Describe in detail the manner in which the well was plugged, indicating where the mud fluid was placed and the method or methods used in introducing it into the hole. If cement or other plugs were used, state the character of same and depth placed, from feet to feet for each plug set.
Plugged hole as follows: Plugged at 800' with 70 sacks of light cement; plugged at 240' with 20 sacks of light cement; plugged at 40' with 10 sacks of light cement. Plug down at 4:30 A. M. September 18, 1973.

RECEIVED
STATE CORPORATION COMMISSION
OCT 23 1973
10-23-73
CONSERVATION DIVISION
Wichita, Kansas

(If additional description is necessary, use BACK of this sheet)
Name of Plugging Contractor Strata Drilling, Inc.
Address P. O. Box 355, Great Bend, Kansas 67530

STATE OF KANSAS, COUNTY OF BARTON, ss.
Charles W. Steincamp (employee of owner) or (owner or operator) of the above-described well, being first duly sworn on oath, says: That I have knowledge of the facts, statements, and matters herein contained and the log of the above-described well as filed and that the same are true and correct. So help me, God.

(Signature) Charles W. Steincamp
Charles W. Steincamp, President
P. O. Box 355, Great Bend, Kansas 67530
(Address)

SUBSCRIBED AND SWORN TO before me this 20th day of September, 19 73

My commission expires December 14, 1973

Elaine H. Taylor
Notary Public.

D R I L L E R S L O G

15-135-20783-0050

#1 Ford

CASING RECORD:
365.52' of used 8-5/8"
surface casing.

COMPANY: Okmar Oil Company
CONTRACTOR: Strata Drilling, Inc.

DESCRIPTION: NE SW SE
Section 11-16S-26W
Ness County, Kansas

TOTAL DEPTH:
4550'

COMMENCED: September 9, 1973
COMPLETED: September 18, 1973

D. & A.

<u>FORMATION</u>	<u>FROM</u>	<u>TO</u>	<u>REMARKS</u>
Shale & Clay	0	380	Ran 365.52' of used 8-5/8" surface casing; set and cemented at 370.52' with 175 sacks of common cement, 2% gel and 3% C. C. Plug down at 12:45 A. M. September 10, 1973.
Shale w/Sand Streaks	380	940	
Sand	940	1815	
Shale, Lime and Sand	1815	2385	
Lime & Shale	2385	3275	
Lime	3275	3482	
Lime & Shale	3482	3682	
Lime	3682	3925	
Lime & Shale	3925	3990	
Lime	3990	4071	
Lime & Shale	4071	4190	
Lime	4190	4260	
Lime & Shale	4260	4415	
Lime	4415	4550	

Rotary Total Depth: 4550'

D. & A.

RECEIVED
STATE CORPORATION COMMISSION
OCT 23 1973
CONSERVATION DIVISION
Wichita, Kansas

Plugged hole as follows: Plugged at 800' with 70 sacks of light cement; plugged at 240' with 20 sacks of light cement; plugged at 40' with 10 sacks of light cement. Plug down at 4:30 A. M. September 18, 1973.

STATE OF KANSAS)
) ss.
COUNTY OF BARTON)

I certify that this is a true and correct copy of the above log to the best of my knowledge.

STRATA DRILLING, INC.

Charles W. Steincamp
Charles W. Steincamp, President

Subscribed and sworn to before me this 20th day of September, 1973.

My Commission Expires:
December 14, 1973

Elaine H. Taylor
Elaine H. Taylor, Notary Public