


Give All Information Completely
Make Required Affidavit
Mail or Deliver Report to:
Conservation Division
State Corporation Commission
211 No. Broadway
Wichita, Kansas

NORTH

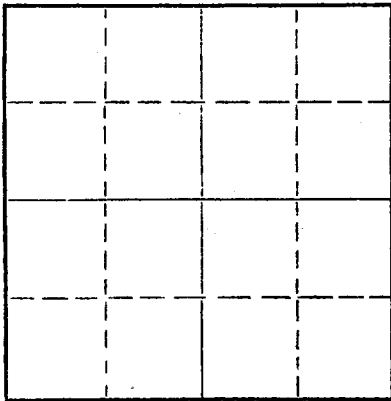

Locate well correctly on above
Section Plat

Harper County. Sec. 24 Twp. 31 Rge. 7-W (E)XXXXXX
Location as "NE/CNW%SW%" or footage from lines SE SE SW
Lease Owner Prime Drilling Company & N. Appleman Co.
Lease Name McKee Well No. 1
Office Address 814 Union Center, Wichita, Kansas
Character of Well (completed as Oil, Gas or Dry Hole) Dry Hole
Date well completed January 10 19 58
Application for plugging filed January 10 19 58
Application for plugging approved January 10 19 58
Plugging commenced January 10 19 58
Plugging completed January 10 19 58
Reason for abandonment of well or producing formation no oil in commercial quantities found

If a producing well is abandoned, date of last production 19
Was permission obtained from the Conservation Division or its agents before plugging was commenced? yes

Name of Conservation Agent who supervised plugging of this well M. A. Rives
Producing formation Depth to top Bottom Total Depth of Well 1759 Feet
Show depth and thickness of all water, oil and gas formations.

OIL, GAS OR WATER RECORDS

CASING RECORD

FORMATION	CONTENT	FROM	TO	SIZE	PUT IN	PULLED OUT
				8-5/8"	255'	none

Describe in detail the manner in which the well was plugged, indicating where the mud fluid was placed and the method or methods used in introducing it into the hole. If cement or other plugs were used, state the character of same and depth placed, from feet to feet for each plug set.

Filled hole with extra heavy rotary mud from total depth to 200'. Set plug #1 at 200' cemented with 20 sacks cement, 1/2 sack Hulls. Filled hole with extra heavy rotary mud from plug #1 to 35'. Set Plug #2 at 35' cemented with 10 sacks cement, 1/2 sack Hulls.

RECEIVED
STATE CORPORATION COMMISSION
JAN 15 1958
CONSERVATION DIVISION
KANSAS

01-15-1958

(If additional description is necessary, use BACK of this sheet)
Name of Plugging Contractor Prime Drilling Company
Address 814 Union Center, Wichita, Kansas

STATE OF KANSAS, COUNTY OF Sedgwick, ss.
R. R. McNicol (employee of owner) or (owner or operator) of the above-described well, being first duly sworn on oath, says: That I have knowledge of the facts, statements, and matters herein contained and the log of the above-described well as filed and that the same are true and correct. So help me God.

(Signature) R.R. McNicol
814 Union Center, Wichita, Kansas
(Address)

SUBSCRIBED AND SWORN to before me this 14th day of January, 19 58

Darlene May
Notary Public.

My commission expires September 30, 1959

PLUGGING
FILE SEC 24 T. 31 R. 7W
BOOK PAGE 76 LINE 32

15-077-00187-00-00

ROTARY DRILLING LOG

OPERATOR: Prime Drilling Company and
N. Appleman Co.

CONTRACTOR: Prime Drilling Company
COMM: 12/23/57
COMP: 1/10/58

MCKEE NO. 1
SE SE SW Sec. 24-31-7W,
Harper County, Kansas

Remarks: Set 8-5/8" surface casing
at 255' cemented with 200 sacks Pozmix,
2% C.C.

Formations:

Sand Red Bed	35'
Red Bed & Shale	700'
Shale & Shells	1160'
Anhydrite	1192'
Lime-Shale	1270'
Shale & Shells	1395'
Sandy Shale & Shells	1460'
Lime & Shale	1753'
Shale & Lime	1920'
Lime & Shale	2460'
Shale & Lime	2730'
Lime & Shale	3165'
Shale & Lime	3549'
Sand	3585'
Lime & Shale	3685'
Sand, Shale & Lime	3785'
Lime, Shale & Sand	3836'
Lime	3960'
Shale Lime	4015'
Lime & Shale	4058'
Lime	4112'
Lime & Shale	4220'
Lime	4263'
Lime & Shale	4315'
Shale & Lime	4340'
Lime	4360'
Lime, Chert - Chat	4464'
Lime	4576'
Lime Cherty	4592'
Lime	4593'
Shale	4720'
Sand	4737'
Sand & Shale	4753'
Sand	4759'
Rotary Total Depth (D&A)	4759'

RECEIVED
STATE CORPORATION COMMISSION

JAN 15 1958

CONSERVATION DIVISION

01-15-1958

We certify the above log is true and
correct to the best of our knowledge
and belief.

PRIME DRILLING COMPANY

R.R. McNicol

R. R. McNicol

Subscribed and sworn to me this 14th day of January, 1958.

My Commission Expires:
September 30, 1959

Darlene May
Darlene May - Notary Public

PLUGGING
FILE SEC 24 T. 31 R. 7W.
BOOK PAGE 76 LINE 32