

15-077-20498-00-00


STATE OF KANSAS
STATE CORPORATION COMMISSION

WELL PLUGGING RECORD

Give All Information Completely
Make Required Affidavit
Mail or Deliver Report to
Conservation Division
State Corporation Comm.
245 North Water
Wichita, KS 67202

Harper County, Sec. 24 Twp. 31S Rge. 7 E/W
Location as "NE/CNW $\frac{1}{4}$ /SW $\frac{1}{4}$ " or footage from lines
C NW NW SW

Lease Owner Anadarko Production Company
Lease Name Malcolmson "A" Well No. #1
Office Address Box 351, Liberal, Kansas 67901
Character of Well (Completed as Oil, Gas or Dry Hole)
Dry Hole

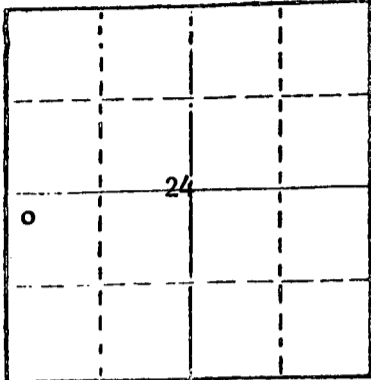

Locate well correctly on above
Section Plat

Date Well completed 11-2 19 78
Application for plugging filed Verbal 19
Application for plugging approved Verbal 19
Plugging commenced 11-2 19 78
Plugging completed 11-2 19 78
Reason for abandonment of well or producing formation
Dry Hole

If a producing well is abandoned, date of last production 19

Was permission obtained from the Conservation Division or
its agents before plugging was commenced? Yes

Name of Conservation Agent who supervised plugging of this well William T. Owen
Producing formation Depth to top Bottom Total Depth of Well 4780'
Show depth and thickness of all water, oil and gas formations.

OIL, GAS OR WATER RECORDS

CASING RECORD

FORMATION	CONTENT	FROM	TO	SIZE	PUT IN	PULLED OUT
				8-5/8"	245'	None

Describe in detail the manner in which the well was plugged, indicating where the mud fluid was placed and the method or methods used in introducing it into the hold. If cement or other plugs were used, state the character of same and depth placed, from feet to feet for each plug set.

Spotted 40 sacks cement 240' to 40'.

Spotted 15 sacks cement 40' to 0'.

5 sacks rathole.

RECEIVED
STATE CORPORATION COMMISSION
DEC - 7 1978
12-07-1978

(If additional description is necessary, use BACK of this sheet)

Name of Plugging Contractor Gabbert-Jones Inc.

STATE OF KANSAS COUNTY OF SEWARD, ss.
Paul Campbell (employee of owner) or (owner)

of the above-described well, being first duly sworn on oath, says: That I have knowledge of the facts, statements, and matters herein contained and the log of the above-described well as filed and that the same are true and correct. So help me God.

Paul Campbell, Div. Prod. Mgr. (Signature)

Paul Campbell
Box 351, Liberal, Kansas 67901
(Address)

SUBSCRIBED AND SWORN TO before me this 5th day of December, 19 78

BEVERLY J. WILLIAMS
Seward County, Kansas
My Appt. Exp. 11/21/82

Beverly J. Williams
Notary Public.

My commission expires

KANSAS DRILLERS LOG


API No. 15 — 077 — 20,498 -00-00
County Number

S. 24 T. 31 R. 7 ^{EW}

Loc. CNW NW SW

County Harper

640 Acres
N

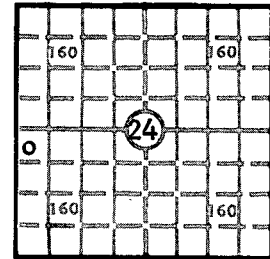

Locate well correctly

Elev.: Gr. 1476

DF _____ KB _____

Operator Anadarko Production Company		
Address Box 351, Liberal, Kansas 67901		
Well No. #1	Lease Name Malcolmson "A"	
Footage Location 2310 feet from (E) (S) line 330 feet from (E) (W) line		
Principal Contractor Gabbert-Jones Inc.		Geologist Gerald A. Becker
Spud Date 10-22-78	Total Depth 4780	P.B.T.D.
Date Completed 11-2-78	Oil Purchaser Dry	

CASING RECORD

Report of all strings set — surface, intermediate, production, etc.

Purpose of string	Size hole drilled	Size casing set (in O.D.)	Weight lbs/ft.	Setting depth	Type cement	Sacks	Type and percent additives
Surface	12-1/4"	8-5/8"	20#	245	Common	225	3% CC

LINER RECORD

PERFORATION RECORD

Top, ft.	Bottom, ft.	Sacks cement	Shots per ft.	Size & type	Depth interval

TUBING RECORD

Size	Setting depth	Packer set at

ACID, FRACTURE, SHOT, CEMENT SQUEEZE RECORD

Amount and kind of material used	Depth interval treated

RECEIVED
STATE CORPORATION COMMISSION

DEC - 7 1978
12-07-1978

CONSERVATION DIVISION
Wichita, Kansas

INITIAL PRODUCTION

Date of first production Dry Hole		Producing method (flowing, pumping, gas lift, etc.)			
RATE OF PRODUCTION PER 24 HOURS	Oil bbls.	Gas MCF	Water bbls.	Gas-oil ratio	CFPB
Disposition of gas (vented, used on lease or sold)			Producing interval (s)		

INSTRUCTIONS: As provided in KCC Rule 82-2-125, within 90 days after completion of a well, one completed copy of this Drillers Log shall be transmitted to the State Geological Survey of Kansas, 4150 Monroe Street, Wichita, Kansas 67209. Copies of this form are available from the Conservation Division, State Corporation Commission, 3830 So. Meridian (P.O. Box 17027), Wichita, Kansas 66217. Phone AC 316-522-2206. If confidential custody is desired, please note Rule 82-2-125. Drillers Logs will be on open file in the Oil and Gas Division, State Geological Survey of Kansas, Lawrence, Kansas 66044.

Operator

Anadarko Production Company

DESIGNATE TYPE OF COMP.: OIL, GAS, DRY HOLE, SWDW, ETC.:

Well No.

#1

Lease Name

Malcolmson "A"

Dry Hole

S 24 T 31SR 7 W

WELL LOG

Show all important zones of porosity and contents thereof; cored intervals, and all drill-stem tests, including depth interval tested, cushion used, time tool open, flowing and shut-in pressures, and recoveries.

SHOW GEOLOGICAL MARKERS, LOGS RUN, OR OTHER DESCRIPTIVE INFORMATION.

FORMATION DESCRIPTION, CONTENTS, ETC.	TOP	BOTTOM	NAME	DEPTH
Sand	0	15		
Redbed	15	252		
Redbed-Shale	252	845		
Shale	845	1390		
Shale-Lime	1390	1700		
Lime	1700	1960		
Lime-Shale	1960	2180		
Shale	2180	2470		
Shale-Lime	2470	3135		
Lime-Shale	3135	3925		
Lime	3925	4270		
Lime-Shert	4270	4360		
Chert-Shale	4360	4595		
Shale-Lime	4595	4727		
Sand	4727	4740		
Sand-Shale	4740	4780		
Total Depth		4780		

USE ADDITIONAL SHEETS, IF NECESSARY, TO COMPLETE WELL RECORD.

Date Received

Paul Campbell
Paul Campbell
Signature

Division Production Manager
Title

Dec 4, 1978
Date