


WELL PLUGGING RECORD

Give All Information Completely
Make Required Affidavit
Mail or Deliver Report to:
Conservation Division
State Corporation Commission
211 No. Broadway
Wichita, Kansas

NORTH

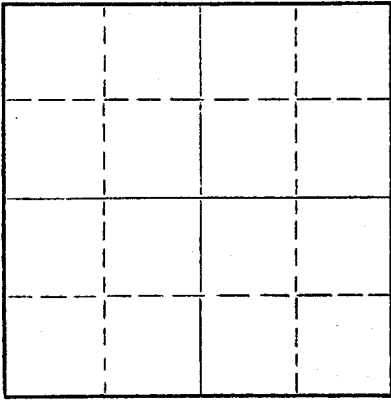

Locate well correctly on above
Section Plat

Harper County. Sec. 22 Twp. 31 Rge. 7 (E) 7 (W)
Location as "NE/CNW/WSW" or footage from lines NE NE NE
Lease Owner Jones, Shelburne & Farmer, Inc.
Lease Name JOSLIN Well No. 1
Office Address Russell, Kansas
Character of Well (completed as Oil, Gas or Dry Hole) Dry
Date well completed 5-23 19 56
Application for plugging filed 5-23 19 56
Application for plugging approved 5-23 19 56
Plugging commenced 5-23 19 56
Plugging completed 5-23 19 56
Reason for abandonment of well or producing formation Dry

If a producing well is abandoned, date of last production _____ 19 ____
Was permission obtained from the Conservation Division or its agents before plugging was commenced? Yes

Name of Conservation Agent who supervised plugging of this well M. A. Rives
Producing formation _____ Depth to top _____ Bottom _____ Total Depth of Well 4978 Feet
Show depth and thickness of all water, oil and gas formations.

| OIL, GAS OR WATER RECORDS | | | | CASING RECORD | | |
|---------------------------|---------|------|----|---------------|--------|------------|
| FORMATION | CONTENT | FROM | TO | SIZE | PUT IN | PULLED OUT |
| | | | | 8-5/8" | 230 | None |
| | | | | | | |
| | | | | | | |
| | | | | | | |
| | | | | | | |
| | | | | | | |
| | | | | | | |

Describe in detail the manner in which the well was plugged, indicating where the mud fluid was placed and the method or methods used in introducing it into the hole. If cement or other plugs were used, state the character of same and depth placed, from _____ feet to _____ feet for each plug set.

- Filled hole with heavy mud
- Pushed plug to 220'
- Dumped 1/2 sack hulls on top of plug
- Mixed 15 sacks cement and dumped on top of hulls
- Filled hole to top
- Pushed plug to 40'
- Dumped in 1/2 sack hulls
- Mixed 10 sacks cement and filled hole to top with same.

(If additional description is necessary, use BACK of this sheet)
Name of Plugging Contractor Jones, Shelburne & Farmer, Inc.
Address Russell, Kansas

STATE OF Kansas COUNTY OF Russell, ss.
JOHN O. FARMER (owner or operator) of the above-described well, being first duly sworn on oath, says: That I have knowledge of the facts, statements, and matters herein contained and the log of the above-described well as filed and that the same are true and correct. So help me God.
(Signature) John O. Farmer
Russell, Kansas
(Address)

SUBSCRIBED AND SWORN TO before me this 29th day of May, 19 56
Lucille Kennedy Notary Public.

My commission expires 10-11-58

PLUGGING
FILE SEC 22 T 31 R 7W
BOOK PAGE 65 LINE 1

RECEIVED
MAY 30 1956
CONSERVATION DIVISION
Wichita, Kansas

