


STATE OF KANSAS
STATE CORPORATION COMMISSION

Give All Information Completely
Make Required Affidavit
Mail or Deliver Report to:
Conservation Division
State Corporation Commission
211 No. Broadway
Wichita, Kansas

15-077-30070-00-00 Form CP-4
WELL PLUGGING RECORD

NORTH

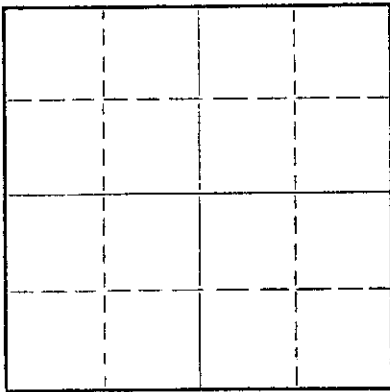

Locate well correctly on above
Section Plat

Harper County, Sec. 18 Twp 31S Rge. 7 (X) W (W)
Location as "NE/CNW/SW" or footage from lines C SE SE
Lease Owner Mack Oil Company
Lease Name Barr Well No. 1
Office Address 812 Union Center Building, Wichita, Kansas 67202
Character of Well (completed as Oil, Gas or Dry Hole) Dry Hole
Date well completed December 18 19.65
Application for plugging filed December 18 19.65
Application for plugging approved December 18 19.65
Plugging commenced December 19 19.65
Plugging completed December 19 19.65
Reason for abandonment of well or producing formation Dry

If a producing well is abandoned, date of last production -- 19
Was permission obtained from the Conservation Division or its agents before plugging was commenced? Yes

Name of Conservation Agent who supervised plugging of this well A. Elving, Pratt, Kansas
Producing formation None Depth to top Bottom Total Depth of Well 4816 Feet
Show depth and thickness of all water, oil and gas formations.

OIL, GAS OR WATER RECORDS

CASING RECORD

FORMATION	CONTENT	FROM	TO	SIZE	PUT IN	PULLED OUT

Describe in detail the manner in which the well was plugged, indicating where the mud fluid was placed and the method or methods used in introducing it into the hole. If cement or other plugs were used, state the character of same and depth placed, from feet to feet for each plug set.

Plugged with 30 sax cement at 240'
25 sax cement from 60' to surface
5 sax cement at rathole and mousehole
Plug down at 1:30 p.m., December 19, 1965

RECEIVED
STATE CORPORATION COMMISSION

12-23-1965
DEC 23 1965

CONSERVATION DIVISION
Wichita, Kansas

(If additional description is necessary, use BACK of this sheet)

Name of Plugging Contractor Mack Oil Company
Address P. O. Box 400, Duncan, Oklahoma 73533

STATE OF KANSAS, COUNTY OF SEDGWICK, ss.
Robert L. Harris (employee of owner) or (owner or operator) of the above-described well, being first duly sworn on oath, says: That I have knowledge of the facts, statements, and matters herein contained and the log of the above-described well as filed and that the same are true and correct. So help me God.

(Signature) Robert L. Harris
812 Union Center Building, Wichita, Kansas
(Address)

SUBSCRIBED AND SWORN TO before me this 22nd day of December, 1965

Elizabeth F. Nice
Elizabeth F. Nice Notary Public.

My commission expires September 21, 1968

15-077-30070-00-00

MACK OIL COMPANY
Duncan, Oklahoma

DRILLERS WELL LOG

Barr #1

Commenced R. D.: 12-2-65
Completed R. D.: 12-18-65
Rotary Total Depth: 4816'

C SE SE - Section 18-31S-7W
Harper County, Kansas
Elevatiop: 1576' Kelly Bushing
Initial Production: Dry
Contractor: Mack Oil Company

<u>STRATA</u>	<u>DEPTH</u>
Top Soil & Sand	0 - 65'
Red Rock & Shells	65 - 255
Red Bed & Shale	255 - 355
Shale	355 - 1370
Shale & Shells	1370 - 1400
Lime & Shale	1400 - 1555
Lime	1555 - 1897
Lime & Shale	1897 - 2015
Lime	2015 - 2189
Lime & Shale	2189 - 2390
Shale With Lime	2390 - 2570
Lime & Shale	2570 - 2745
Shale & Lime	2745 - 3016
Lime	3016 - 3350
Lime & Shale	3350 - 3370
Lime	3370 - 3620
Lime & Shale	3620 - 3878
Lime	3878 - 4430
Chat	4430 - 4621
Lime & Shale	4621 - 4681
Shale & Lime	4681 - 4761
Lime & Shale	4761 - 4794
Simpson Sand	4794 - 4816'

RECEIVED
STATE CORPORATION COMMISSION

DEC 23 1965
12-23-1965
CONSERVATION DIVISION
Wichita, Kansas

I hereby certify that the above is a true and correct log of said well as reflected by the daily drilling reports.

MACK OIL COMPANY

By Robert L. Harris
Robert L. Harris

Signed and sworn to in my presence this 22nd day of December, 1965 by Robert L. Harris, representative of Mack Oil Company.

Elizabeth F. Nice
Elizabeth F. Nice, Notary Public

My commission expires September 21, 1968