

STATE OF KANSAS  
STATE CORPORATION COMMISSION


Form CP-4

15-135-20487-0000  
WELL PLUGGING RECORD

Give All Information Completely  
Make Required Affidavit  
Mail or Deliver Report to:  
Conservation Division  
State Corporation Commission  
212 No. Market  
Wichita, Kansas 67202

Ness County, Sec. 9 Twp. 16S Rge. (E) 26 (W)  
SW NW SW

Location as "NE/CNW/SW" or footage from lines \_\_\_\_\_  
Lease Owner Okmar Oil Company  
Lease Name Peters Well No. 1  
Office Address 1130 Wichita Plaza, Wichita, Kansas 67202  
Character of Well (completed as Oil, Gas or Dry Hole) Dry Hole  
Date well completed October 1 19 71  
Application for plugging filed October 1 19 71  
Application for plugging approved October 1 19 71  
Plugging commenced October 1 19 71  
Plugging completed October 1 19 71  
Reason for abandonment of well or producing formation Dry Hole

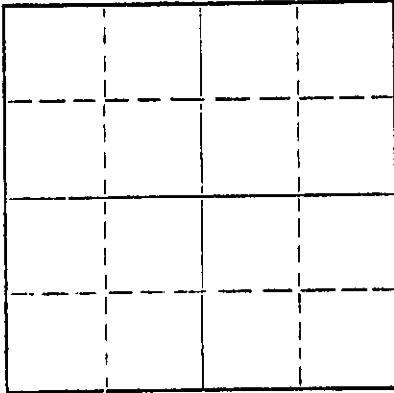

Locate well correctly on above Section Plat

If a producing well is abandoned, date of last production \_\_\_\_\_ 19 \_\_\_\_  
Was permission obtained from the Conservation Division or its agents before plugging was commenced? Yes

Name of Conservation Agent who supervised plugging of this well Leo Massey, Hays, Kansas  
Producing formation \_\_\_\_\_ Depth to top \_\_\_\_\_ Bottom \_\_\_\_\_ Total Depth of Well 4564 Feet  
Show depth and thickness of all water, oil and gas formations.

OIL, GAS OR WATER RECORDS

CASING RECORD

FORMATION	CONTENT	FROM	TO	SIZE	PUT IN	PULLED OUT
	8-5/8"	0	303.32'			

Describe in detail the manner in which the well was plugged, indicating where the mud fluid was placed and the method or methods used in introducing it into the hole. If cement or other plugs were used, state the character of same and depth placed, from \_\_\_\_\_ feet to \_\_\_\_\_ feet for each plug set.  
Plugged as follows: Plugged at 800' with 70 sacks of common cement; plugged at 270' with 10 sacks of common cement; plugged at 40' with 10 sacks of common cement. Plug down at 9:30 A. M. October 1, 1971.

RECEIVED  
STATE CORPORATION COMMISSION  
OCT 14 1971  
CONSERVATION DIVISION  
Wichita, Kansas  
10-14-71

(If additional description is necessary, use BACK of this sheet)  
Name of Plugging Contractor Strata Drilling, Inc.  
Address P. O. Box 355, Great Bend, Kansas 67530

STATE OF KANSAS, COUNTY OF BARTON, ss.  
Charles W. Steincamp (employee of owner) or ~~owner~~ of the above-described well, being first duly sworn on oath, says: That I have knowledge of the facts, statements, and matters herein contained and the log of the above-described well as filed and that the same are true and correct. So help me God.

(Signature) Charles W. Steincamp  
Charles W. Steincamp, President  
P. O. Box 355, Great Bend, Kansas 67530  
(Address)

Subscribed and Sworn to before me this 1st day of October, 19 71

My commission expires December 14, 1973

Elaine H. Taylor  
Notary Public.

SP

D R I L L E R S   L O G

#1 Peters

15-13S-20487-0000

CASING RECORD:  
297.32' of new 8-5/8"  
surface casing.

COMPANY: Okmar Oil Company  
CONTRACTOR: Strata Drilling, Inc.

DESCRIPTION: SW NW SW  
Section 9-16S-26W  
Ness County, Kansas

TOTAL DEPTH:  
4564'

COMMENCED: September 21, 1971  
COMPLETED: October 1, 1971

D. & A.

<u>FORMATION</u>	<u>FROM</u>	<u>TO</u>	<u>REMARKS</u>
Clay & Sand	0	30	Ran 297.32' of new 8-5/8" surface casing; set and cemented at 303.32' with 160 sacks of regular cement, 2% gel and 3% C. C. Plug down at 9:50 P. M. September 21, 1971.
Sand, Shale & Post Rock	30	333	
Shale	333	483	
Shale w/Sand Streaks	483	1025	
Red Bed, Shale w/Sand Streaks	1025	1405	
Red Bed, Shale & Shells	1405	1457	
#1 Anhydrite	1457	1475	
Red Bed & Shale	1475	1577	
Dakota Sand	1577	1781	
Red Bed & Shale	1781	2045	
#2 Anhydrite	2045	2081	
Lime & Shale	2081	2323	
Shale & Shells	2323	2635	
Shale, Lime w/Broken Lime	2635	2821	
Lime & Shale	2821	3679	
Lime	3679	4508	
Lime & Chert	4508	4564	

RECEIVED  
STATE CORPORATION COMMISSION  
OCT 14 1971  
CONSERVATION DIVISION  
Wichita, Kansas

Rotary Total Depth 4564'

D. & A.

Plugged as follows: Plugged at 800' with 70 sacks of common cement; plugged at 270' with 10 sacks of common cement; plugged at 40' with 10 sacks of common cement. Plug down at 9:30 A. M. October 1, 1971.

STATE OF KANSAS )  
                  ) ss.  
COUNTY OF BARTON)

I certify that this is a true and correct copy of the above log to the best of my knowledge.

STRATA DRILLING, INC.

Charles W. Steincamp  
Charles W. Steincamp, President

Subscribed and sworn to before me this 1st day of October, 1971.

My Commission Expires:  
December 14, 1973

Elaine H. Taylor  
Elaine H. Taylor, Notary Public