

15-135-20466-0000

STATE OF KANSAS
STATE CORPORATION COMMISSION


Form CP-4

Give All Information Completely
Make Required Affidavit
Mail or Deliver Report to:
Conservation Division
State Corporation Commission
212 No. Market
Wichita, Kansas 67202

WELL PLUGGING RECORD

Ness County, Sec. 9 Twp. 16S Rge. (E) 26 (W)

Location as "NE/CNWxSWx" or footage from lines C/SE NW
Lease Owner Okmar Oil Company
Lease Name Vera Well No. 1
Office Address 1130 Wichita Plaza, Wichita, Kansas 67202
Character of Well (completed as Oil, Gas or Dry Hole) Dry Hole
Date well completed August 22 1971
Application for plugging filed August 22 1971
Application for plugging approved August 22 1971
Plugging commenced August 22 1971
Plugging completed August 22 1971
Reason for abandonment of well or producing formation Dry Hole

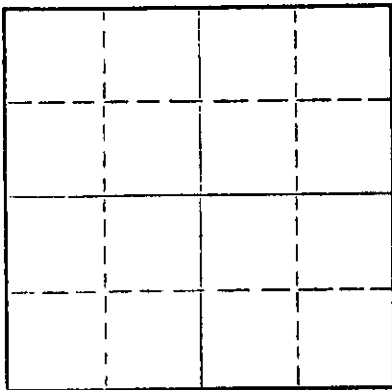

Locate well correctly on above Section Plat

If a producing well is abandoned, date of last production 19
Was permission obtained from the Conservation Division or its agents before plugging was commenced? Yes

Name of Conservation Agent who supervised plugging of this well Leo Massey, Hays, Kansas
Producing formation Depth to top Bottom Total Depth of Well 4600 Feet
Show depth and thickness of all water, oil and gas formations.

OIL, GAS OR WATER RECORDS

CASING RECORD

FORMATION	CONTENT	FROM	TO	SIZE	PUT IN	PULLED OUT
	8-5/8"	0	311.81'			

Describe in detail the manner in which the well was plugged, indicating where the mud fluid was placed and the method or methods used in introducing it into the hole. If cement or other plugs were used, state the character of same and depth placed, from feet to feet for each plug set.
Plugged as follows: Plugged at 800' with 70 sacks of common cement; plugged at 280' with 20 sacks of common cement; plugged at 40' with 10 sacks of common cement. Plug down at 9:15 P. M. August 22, 1971.

RECEIVED
STATE CORPORATION COMMISSION
AUG 27 1971
CONSERVATION DIVISION
Wichita, Kansas


8-27-71

(If additional description is necessary, use BACK of this sheet)

Name of Plugging Contractor Strata Drilling, Inc.
Address P. O. Box 355, Great Bend, Kansas 67530

STATE OF KANSAS, COUNTY OF BARTON, ss.
Charles W. Steincamp (employee of owner) or (owner) of the above-described well, being first duly sworn on oath, says: That I have knowledge of the facts, statements, and matters herein contained and the log of the above-described well as filed and that the same are true and correct. So help me God.

(Signature) Charles W. Steincamp
Charles W. Steincamp, President
P. O. Box 355, Great Bend, Kansas 67530
(Address)

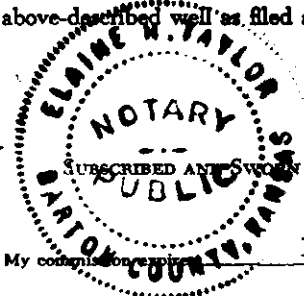

Subscribed and sworn to before me this 23rd day of August, 1971

December 14, 1973

Elaine H. Taylor
Notary Public.

D R I L L E R S L O G

15-135-20466-0050

#1 Vera

CASING RECORD:
305.81' of new 8-5/8"
surface casing.

COMPANY: Okmar Oil Company
CONTRACTOR: Strata Drilling, Inc.

DESCRIPTION: C/SE NW
Section 9-16S-26W
Ness County, Kansas

TOTAL DEPTH:
4600'

COMMENCED: August 13, 1971
COMPLETED: August 22, 1971

D. & A.

<u>FORMATION</u>	<u>FROM</u>	<u>TO</u>	<u>REMARKS</u>
Post Rock, Sand & Shale	0	338	Ran 305.81' of new 8-5/8" surface casing; set and cemented at 311.81' with 160 sacks of regular cement, 2% gel and 3% C. C. Plug down at 9:30 P. M. August 13, 1971.
Shale	338	526	
Shale w/Sand Streaks	526	875	
Red Bed, Shale & Shells w/ Sand Streaks	875	1230	
Red Bed and Shale	1230	1475	
#1 Anhydrite	1475	1485	
Shale & Red Bed	1485	1609	
Sand	1609	1818	
Shale	1818	2058	
#2 Anhydrite	2058	2095	
Shale	2095	2268	
Shale & Shells	2268	2600	
Shells, Shale w/Broken Lime	2600	2740	
Lime & Shale	2740	3045	
Shale w/Broken Lime	3045	3219	
Lime & Shale	3219	4000	
Lime	4000	4540	
Cherty Lime	4540	4560	
Chert, Lime & Shale	4560	4568	
Cherty Lime	4568	4600	

RECEIVED
STATE CORPORATION COMMISSION
AUG 27 1971
CONSERVATION DIVISION
Wichita, Kansas

D. & A.

Rotary Total Depth 4600'

Plugged hole as follows: Plugged at 800' with 70 sacks of common cement; plugged at 280' with 20 sacks of common cement; plugged at 40' with 10 sacks of common cement. Plug down at 9:15 P. M. August 22, 1971.

STATE OF KANSAS)
) ss.
COUNTY OF BARTON)

I certify that this is a true and correct copy of the above log to the best of my knowledge.

STRATA DRILLING, INC.

Charles W. Steincamp
Charles W. Steincamp, President

Subscribed and sworn to before me this 23rd day of August, 1971.

My Commission Expires:
December 14, 1973

Elaine H. Taylor
Elaine H. Taylor, Notary Public