

15-165-19043-0000

Give All Information Completely
Make Required Affidavit
Mail or Deliver Report to:
Conservation Division
State Corporation Commission
211 No. Broadway
Wichita, Kansas

WELL PLUGGING RECORD

Rush County. Sec. 36 Twp. 19 Rge. 20W (E) (W)

Location as "NE/CNW/SW" or footage from lines C NE/4 NE/4

Lease Owner Mull Drilling Co.

Lease Name Smith 'D' Well No. 1

Office Address 1625 Wichita Plaza, Wichita, Kansas

Character of Well (completed as Oil, Gas or Dry Hole) Dry Hole

Date well completed October 13, 1964

Application for plugging filed October 13, 1964

Application for plugging approved October 13, 1964


Plugging commenced October 13th, 1964

Plugging completed October 13th, 1964

Reason for abandonment of well or producing formation Anhydrite formation too low structurally

If a producing well is abandoned, date of last production 19

Was permission obtained from the Conservation Division or its agents before plugging was commenced? yes

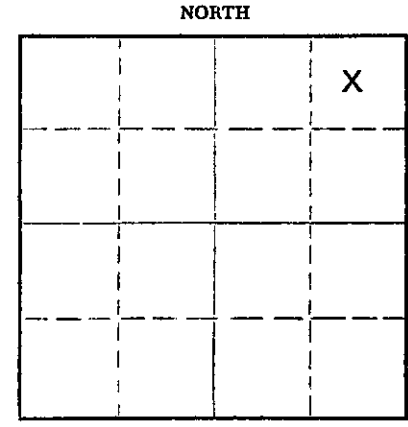

Locate well correctly on above Section Plat

Name of Conservation Agent who supervised plugging of this well Eldon Petty

Producing formation _____ Depth to top _____ Bottom _____ Total Depth of Well 2593 Feet

Show depth and thickness of all water, oil and gas formations.

OIL, GAS OR WATER RECORDS

CASING RECORD

FORMATION	CONTENT	FROM	TO	SIZE	PUT IN	PULLED OUT
				8-5/8	350 ft.	-0-

Describe in detail the manner in which the well was plugged, indicating where the mud fluid was placed and the method or methods used in introducing it into the hole. If cement or other plugs were used, state the character of same and depth placed, from _____ feet to _____ feet for each plug set.

First Plug set at 350' with 20 sacks cement.
Second plug set at 180' with 20 sacks cement.
Set top plug at 40' with 10 sacks cement.

RECEIVED
STATE CORPORATION COMMISSION
OCT 26 1964
10-26-64
CONSERVATION DIVISION
Wichita, Kansas

(If additional description is necessary, use BACK of this sheet)

Name of Plugging Contractor Walters Drilling Co.
Address 510 Orpheum, Wichita, Kansas

STATE OF KANSAS, COUNTY OF SEDGWICK, ss.

Robert F. Walters (owner or operator) of the above-described well, being first duly sworn on oath, says: That I have knowledge of the facts, statements, and matters herein contained and the log of the above-described well as filed and that the same are true and correct. So help me God.

(Signature) Robert F. Walters
ROBERT F. WALTERS, Partner
510 Orpheum Building, Wichita, Kansas (Address)

SUBSCRIBED AND SWORN TO before me this 23rd day of October, 1964

My commission expires January 11, 1967
Velma L. Deines Notary Public.



SMITH 'D' #1

LOCATION: C NE/4 NE/4 Section 36-19³-20W
Rush County, Kansas

OPERATOR: MULL DRILLING CO., INC.

CONTRACTOR: WALTERS DRILLING CO.

DATE SPUDDED: October 10th, 1964
DATE COMPLETED: October 14th, 1964

SURFACE CASING: 8-5/8" set at 350' with 185 sacks cement

ELEVATION: 2273 GL
2275 DF
2278 KB

LOG

(Figures indicate bottom of formation)

Surface Soil	0-20'
Shale	360'
Shale & Shells	760'
Shale	860'
Sand	1070'
Shale & Red Bed	1345'
Shale	1441'
Anhydrite	1469'
Shale & Shells	1700'
Shale	2210'
Lime & Shale	2405'
Lime	2593'
Total Depth	2593'

RECEIVED
STATE CORPORATION COMMISSION

OCT 26 1964
10-26-64

CONSERVATION DIVISION
Wichita, Kansas

The undersigned, Robert F. Walters, hereby certifies that the above log is a true and correct log of the formations encountered in drilling the above noted well as reflected by the Daily Drilling Reports.

WALTERS DRILLING CO.



ROBERT F. WALTERS, Partner

Subscribed and sworn to before me
this 22nd day of October, 1964.


Velma L. Deines, Notary Public

My Commission Expires:

January 11, 1967.