

NOTICE OF INTENTION TO DRILL

(see rules on reverse side)

Starting Date April ²⁶~~18~~ 1987
month day year

API Number 15- 135-23, 116-0000

OPERATOR: License # ... 7200

NE. SE. ^{NW}~~SW~~ 4 Sec. 24. Twp. 16. S. Rg. 26. W ~~SW~~ West

Name Scott T. Lutz

..... 3630 Ft. from South Line of Section

Address P. O. Box Drawer D

..... 2970 Ft. from East Line of Section

City/State/Zip .. Shell Knob, Mo. 65747

(Note: Locate well on Section Plat on reverse side)

Contact Person .. H. L. Maddox Scott Lutz

Nearest lease or unit boundary line 330 feet

Phone 316-653-4178 417-858-6628

County Ness

CONTRACTOR: License # 5301

Lease Name McKinnis #2 Well # 2

Name Red Tiger Drilling Co

Ground surface elevation 2583 feet MSL

City/State Wichita, Kansas

Domestic well within 330 feet: yes no

Well Drilled For: Well Class: Type Equipment:

Municipal well within one mile: yes no Oil SWD Infield Mud Rotary

Depth to bottom of fresh water 80 feet

 Gas Inj Pool Ext. Air Rotary

Depth to bottom of usable water 1175 feet

 OWWO Expl Wildcat CableSurface pipe by Alternate: 1 2

If OWWO: old well info as follows:

Surface pipe planned to be set 300 feet

Operator

Conductor pipe required None

Well Name

Projected Total Depth 4600 feet

Comp Date Old Total Depth

Formation Mississippi

I certify that well will comply with K.S.A. 55-101, et seq., plus eventually plugging hole to KCC specifications.

Date 4-18-87 Signature of Operator or Agent Scott T. Lutz Title Owner-Operator

For KCC Use:

Conductor Pipe Required feet; Minimum Surface Pipe Required 200 feet per Alt. 42

This Authorization Expires 10-21-87 Approved By 4-21-87


Pat/Koz

Must be filed with the K.C.C. five (5) days prior to commencing well
This card void if drilling not started within six (6) months of date received by K.C.C.

Important procedures to follow:

1. Notify District office before setting surface casing.
2. Set surface casing by circulating cement to the top.
3. File completion forms ACO-1 with K.C.C. within 90 days of well completion, following instructions on ACO-1, side 1, and including copies of wireline logs.
4. Notify District office 48 hours prior to old well workover or re-entry.
Prior to filing Intent, prepare a proposed plugging plan in case well is D & A, then obtain approval of plan when calling district office prior to setting surface pipe.
Submit plugging report (CP-4) to K.C.C. after plugging is completed.
5. Obtain an approved injection docket number before disposing of salt water.
8. Notify K.C.C. within 10 days when injection commences or terminates.
9. If an alternate 2 completion, cement in the production pipe from below any usable water to surface within 120 days of spud date.

A Regular Section of Land 1 Mile = 5,280 Ft.

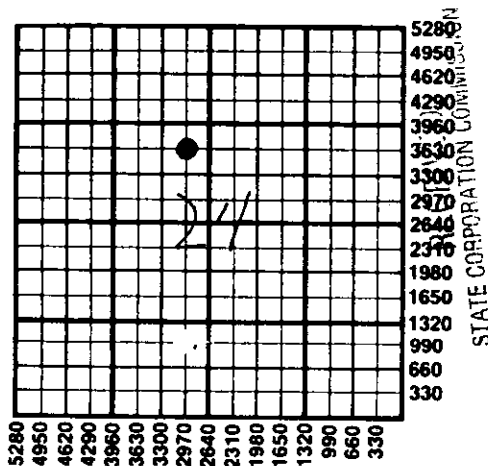

APR 21 1987
4-21-87
CONSERVATION DIVISION
Wichita, Kansas

State Corporation Commission of Kansas
Conservation Division
200 Colorado Derby Building
Wichita, Kansas 67202
(316) 263-3238