

NOTICE OF INTENTION TO DRILL

(see rules on reverse side)

Starting Date May 5 1986 month day year

API Number 15-135-23,025-0000

OPERATOR: License # 7200 Name Scott T. Lutz Address P. O. Drawer D City/State/Zip Shell Knob, Missouri 65747 Contact Person H.L. Maddox Scott Lutz Phone 316-653-4178 417-858-6628

NW NW SE/4 Sec. 24 Twp. 16 S, Rg. 26 X West 2310 Ft. from South Line of Section 2310 Ft. from East Line of Section

(Note: Locate well on Section Plat on reverse side)

CONTRACTOR: License # Name Not Selected City/State

Nearest lease or unit boundary line 330 feet County Ness Lease Name Nichepor Well # 8

Well Drilled For: X Oil SWD Infield Mud Rotary Gas Inj X Pool Ext Air Rotary OWWO Expl Wildcat Cable

Ground surface elevation ? feet MSL Domestic well within 330 feet: yes no Municipal well within one mile: yes no

If OWWO: old well info as follows:

Operator Well Name Comp Date Old Total Depth

Depth to bottom of fresh water 80 Depth to bottom of usable water 975 1175 Surface pipe by Alternate: (refer below) 1 2 X

I certify that well will comply with K.S.A. 55-101, et seq., plus eventually plugging hole to KCC specifications. Date 4-30-1986 Signature of Operator or Agent Scott T. Lutz Title Owner/Operator

Surface pipe planned to be set 300 feet Conductor pipe required NONE Projected Total Depth 4600 feet

For KCC Use:

Conductor Pipe Required feet; Minimum Surface Pipe Required 250 feet per Alt. This Authorization Expires 11-2-86 Approved By [Signature]


PC/H/KH/E

Must be filed with the K.C.C. five (5) days prior to commencing well  
This card void if drilling not started within six (6) months of date received by K.C.C.

**Important procedures to follow:**

1. Notify District office before setting surface casing.
2. Set surface casing by circulating cement to the top.
3. File completion forms ACO-1 with K.C.C. within 90 days of well completion, following instructions on ACO-1, side 1, and including copies of wireline logs.
4. Notify District office 48 hours prior to old well workover or re-entry.
5. Prior to filing Intent, prepare a proposed plugging plan in case well is D & A, then obtain approval of plan when calling district office prior to setting surface pipe.
6. Submit plugging report (CP-4) to K.C.C. after plugging is completed.
7. Obtain an approved injection docket number before disposing of salt water.
8. Notify K.C.C. within 10 days when injection commences or terminates.
9. If an alternate 2 completion, cement in the production pipe from below any usable water to surface within 120 days of spud date.

**A Regular Section of Land  
1 Mile = 5,280 Ft.**

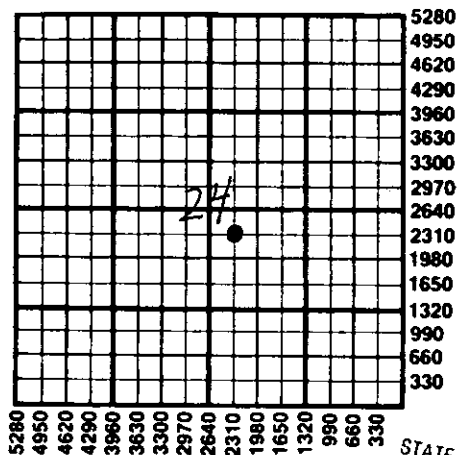

RECEIVED  
STATE CORPORATION COMMISSION

MAY 02 1986  
5-2-86  
CONSERVATION DIVISION  
Wichita, Kansas

State Corporation Commission of Kansas  
Conservation Division  
200 Colorado Derby Building  
Wichita, Kansas 67202  
(316) 263-3238