

CARD MUST BE TYPED

NOTICE OF INTENTION TO DRILL

CARD MUST BE SIGNED

State of Kansas
(see rules on reverse side)

Starting Date: Jan 15 1986
month day year

API Number 15- 135-22,994-6000 East

OPERATOR: License # 7200

SE SE NW /4 Sec 24 Twp 16 S, Rge 26 West
(location)

Name Scott T. Lutz

Address P O Drawer D

City/State/Zip Shell Knob, Mo 65747

Contact Person H. L. Maddox Scott Lutz

Phone 316-653-4178 417-858-6628

2970 Ft North from Southeast Corner of Section

2970 Ft West from Southeast Corner of Section

(Note: Locate well on Section Plat on reverse side)

CONTRACTOR: License #

Name Not Selected

City/State

Nearest lease or unit boundary line 330 feet.

County Ness

Lease Name McKinnis B Well# 1

Domestic well within 330 feet: yes no

Municipal well within one mile: yes no

Well Drilled For: Well Class: Type Equipment:

Oil Swd Infield Mud Rotary

Gas Inj Pool Ext. Air Rotary

OWWO Expl Wildcat Cable

If OWWO: old well info as follows:

Operator

Well Name

Comp Date Old Total Depth

Projected Total Depth 4600 feet

Projected Formation at TD Mississippi

Expected Producing Formations Miss

Depth to Bottom of fresh water 80 feet

Lowest usable water formation Dakota

Depth to Bottom of usable water 975 feet

Surface pipe by Alternate: 1 2 (refer to below)

Surface pipe to be set 300 feet

Conductor pipe if any required NA feet

Ground surface elevation feet MSI

This Authorization Expires 7-6-86

Approved By 1-6-85

Dakota Sec will be cemented


I certify that we will comply with K.S.A. 55-101, et seq., plus eventually plugging hole to K.C.C. specifications.

Date 1/2/86 Signature of Operator or Agent Scott T. Lutz Title Owner/Operator

Must be filed with the K.C.C. five (5) days prior to commencing well
This card void if drilling not started within six (6) months of date received by K.C.C.

Important procedures to follow:

**A Regular Section of Land
1 Mile = 5,280 Ft.**

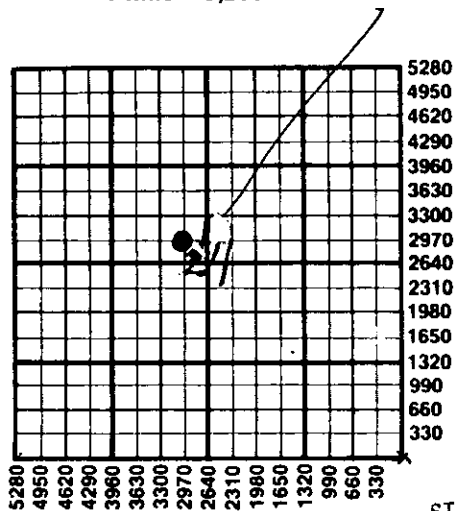

(SEC 24)

1. Notify District office before setting surface casing.
2. Set surface casing by circulating cement to the top.
3. File completion forms ACO-1 with K.C.C. within 90 days of well completion, following instructions on ACO-1, side 1, and including copies of wireline logs.
4. Notify District office 48 hours prior to old well workover or re-entry.
5. Prior to plugging, prepare a plugging plan, then obtain agreement from the appropriate district office for an approved plugging plan.
6. Submit plugging report (CP-4) to K.C.C. after plugging is completed.
7. Obtain an approved injection docket number before disposing of salt water.
8. Notify K.C.C. within 10 days when injection commences or terminates.
9. If an alternate 2 completion, cement in the production pipe from below any usable water to surface within 120 days of spud date.

RECEIVED
STATE CORPORATION COMMISSION

1-6-86
JAN 6 1986

CONSERVATION DIVISION
Wichita, Kansas

State Corporation Commission of Kansas
Conservation Division
200 Colorado Derby Building
Wichita, Kansas 67202
(316) 263-3238