

CARD MUST BE TYPED

State of Kansas
NOTICE OF INTENTION TO DRILL
(see rules on reverse side)

CARD MUST BE SIGNED

Starting Date: 11 10 85
month day year

API Number 15- 135-22,961-0000 East
..SW.. SW NE/4 Sec 24 Twp 16 S, Rge 26 West
(location)

OPERATOR: License # 7200
Name Scott T. Lutz
Address P.O. Drawer D
City/State/Zip Shell Knob, Mo 65747
Contact Person H. L. Maddox Scott Lutz
Phone 316-653-4178 417-858-6628

..... 2970 Ft North from Southeast Corner of Section
..... 2310 Ft West from Southeast Corner of Section
(Note: Locate well on Section Plat on reverse side)

CONTRACTOR: License #
Name Not Selected
City/State

Nearest lease or unit boundary line 330 feet.
County Ness
Lease Name McKinnis Well# 1
Domestic well within 330 feet : yes no
Municipal well within one mile : yes no

Well Drilled For: Well Class: Type Equipment:
 Oil Swd Infield Mud Rotary
 Gas Inj Pool Ext. Air Rotary
 OWWO Expl Wildcat Cable

Depth to Bottom of fresh water 80 feet
Lowest usable water formation Dakota
Depth to Bottom of usable water 975 feet
Surface pipe by Alternate : 1 2 (refer below)
Surface pipe to be set 300 feet
Conductor pipe if any required NA feet
Ground surface elevation feet MSL.
This Authorization Expires ~~11-1-85~~ 5-4-86
Approved By 11-4-85 *[Signature]*


If OWWO: old well info as follows:
Operator
Well Name
Comp Date Old Total Depth
Projected Total Depth 4600 feet
Projected Formation at TD Miss
Expected Producing Formations Miss

I certify that we will comply with K.S.A. 55-101, et seq., plus eventually plugging hole to K.C.C. specifications. Dakota Sec will be cemented at the time the prod casing is run. *[Signature]*
Date 11-1-85 Signature of Operator or Agent Title Owner/Operator

Must be filed with the K.C.C. five (5) days prior to commencing well
This card void if drilling not started within six (6) months of date received by K.C.C.

Important procedures to follow :

**A Regular Section of Land
1 Mile = 5,280 Ft.**

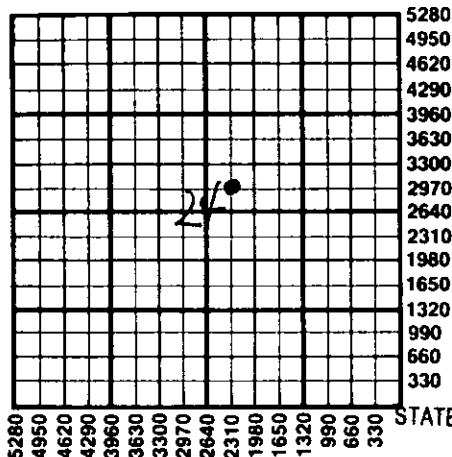

1. Notify District office before setting surface casing.
2. Set surface casing by circulating cement to the top.
3. File completion forms ACO-1 with K.C.C. within 90 days of well completion, following instructions on ACO-1, side I, and including copies of wireline logs.
4. Notify District office 48 hours prior to old well workover or re-entry.
5. Prior to plugging, prepare a plugging plan, then obtain agreement from the appropriate district office for an approved plugging plan.
6. Submit plugging report (CP-4) to K.C.C. after plugging is completed.
7. Obtain an approved injection docket number before disposing of salt water.
8. Notify K.C.C. within 10 days when injection commences or terminates.
9. If an alternate 2 completion, cement in the production pipe from below (and) usable water to surface within 120 days of spud date.

RECEIVED

STATE CORPORATION COMMISSION

NOV 4 1985
11-4-85
CONSERVATION DIVISION
Wichita, Kansas

State Corporation Commission of Kansas
Conservation Division
200 Colorado Derby Building
Wichita, Kansas 67202
(316) 263-3238