

CARD MUST BE TYPED

State of Kansas
NOTICE OF INTENTION TO DRILL

CARD MUST BE SIGNED

(see rules on reverse side)

Starting Date: 8 10 85
month day year

API Number IS- 135-22,901-0000

OPERATOR: License # 7200

~~SW~~ NW SW4 Sec 24 Twp 16 S, Rge 26 East
(location) West

Name Scott T. Lutz

Address P O Drawer D

City/State/Zip Shell Knob, Mo. 65747

Contact Person H. L. Maddox Scott Lutz

Phone 316-653-4178 417-858-6628

..... 1650 Ft North from Southeast Corner of Section
..... 4290 Ft West from Southeast Corner of Section
(Note: Locate well on Section Plat on reverse side)

CONTRACTOR: License #

Name Not Selected

City/State

Nearest lease or unit boundary line 990 feet.
County Ness
Lease Name Jones Well# 2

Well Drilled For: Well Class: Type Equipment:

Oil Swd Infield Mud Rotary
 Gas Inj Pool Ext. Air Rotary
 OWWO Expl Wildcat Cable

Domestic well within 330 feet: yes no
Municipal well within one mile: yes no

If OWWO: old well info as follows:

Operator
Well Name
Comp Date Old Total Depth
Projected Total Depth 4600 feet
Projected Formation at TD Miss
Expected Producing Formations Miss

Depth to Bottom of fresh water 80 feet
Lowest usable water formation Dakota
Depth to Bottom of usable water 925 925 feet
Surface pipe by Alternate: 1 2 ** (refer Below)
Surface pipe to be set 300 feet
Conductor pipe if any required NA feet
Ground surface elevation feet MSL.
This Authorization Expires 2-9-86

I certify that we will comply with K.S.A. 55-101, et seq., plus eventually plugging hole to K.C.C. specifications. cemented at the time the prod. casing is run.

Date 10-5-85 Signature of Operator or Agent Scott T. Lutz

Approved By 8-9-85 Dakota section will be. [Signature]
Title Owner-Operator.....

Rec'd for KDHE


**Must be filed with the K.C.C. five (5) days prior to commencing well
 This card void if drilling not started within six (6) months of date received by K.C.C.**

**A Regular Section of Land
 1 Mile = 5,280 Ft.**

RECEIVED
 STATE CORPORATION COMMISSION
 WICHITA, KANSAS
 58-6-85
 AUG 9 6 09 AM
 1985

Important procedures to follow:

1. Notify District office before setting surface casing.
2. Set surface casing by circulating cement to the top.
3. File completion forms ACO-1 with K.C.C. within 90 days of well completion, following instructions on ACO-1, side 1, and including copies of wireline logs.
4. Notify District office 48 hours prior to old well workover or re-entry.
5. Prior to plugging, prepare a plugging plan, then obtain agreement from the appropriate district office for an approved plugging plan.
6. Submit plugging report (CP-4) to K.C.C. after plugging is completed.
7. Obtain an approved injection docket number before disposing of salt water.
8. Notify K.C.C. within 10 days when injection commences or terminates.
9. If an alternate 2 completion, cement in the production pipe from below any usable water to surface within 120 days of spud date.

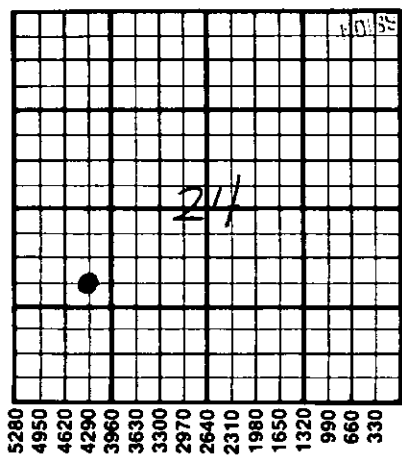

**State Corporation Commission of Kansas
 Conservation Division
 200 Colorado Derby Building
 Wichita, Kansas 67202
 (316) 263-3238**