

CARD MUST BE TYPED

State of Kansas
NOTICE OF INTENTION TO DRILL
(see rules on reverse side)

CARD MUST BE SIGNED

Starting Date: 4 14 85
 month day year

API Number IS- 135-22,800-0000

OPERATOR: License # 7200

C N/2, SW/4, SE/4 Sec 24, Twp 16 S, Rge 26 E
(location) East West

Name Scott T. Lutz

Address P. O. Drawer D

City/State/Zip Shell Knob, Missouri 65747

Contact Person H. L. Maddox Scott T. Lutz

Phone 316-653-4178 417-858-6628

.....990..... Ft North from Southeast Corner of Section

.....1980..... Ft West from Southeast Corner of Section

(Note: Locate well on Section Plat on reverse side)

Nearest lease or unit boundary line 660 feet.

County Ness

Lease Name Nichapor Well# 5

Domestic well within 330 feet: yes no

Municipal well within one mile: yes no

Well Drilled For: Well Class: Type Equipment:

Oil Swd Infield Mud Rotary

Gas Inj Pool Ext. Air Rotary

OWWO Expl Wildcat Cable

Depth to Bottom of fresh water 80 feet

Lowest usable water formation Dakota

Depth to Bottom of usable water 925 feet

Surface pipe by Alternate: 1 2

Surface pipe to be set 300 feet

Conductor pipe if any required feet

Ground surface elevation feet MSL

This Authorization Expires 10-3-85

Approved By 4-3-85 [Signature]

If OWWO: old well info as follows:

Operator

Well Name

Comp Date Old Total Depth

Projected Total Depth 4580 feet

Projected Formation at TD Miss

Expected Producing Formations Miss

I certify that we will comply with K.S.A. 55-101, et seq., plus eventually plugging hole to K.C.C. specifications.

Date 4-1-85 Signature of Operator or Agent

Scott T. Lutz


Title Owner-Operator

MHC/KOHE 4-3-85

Must be filed with the K.C.C. five (5) days prior to commencing well
This card will not be valid if not started within six (6) months of date received by K.C.C.
STATE CORPORATION COMMISSION

APR 03 1985
4-3-85

A Regular Section of Land CONSERVATION DIVISION
1 Mile = 5,280 Ft. Wichita, Kansas

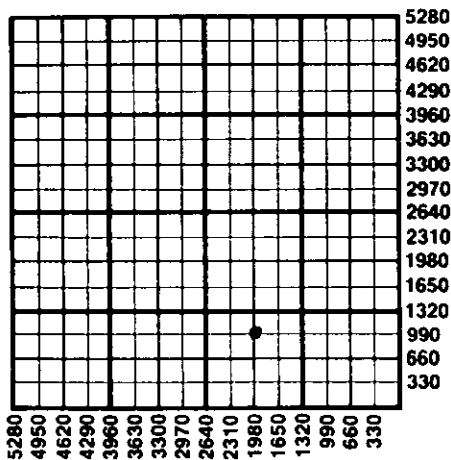

Important procedures to follow:

1. Notify District office before setting surface casing.
2. Set surface casing by circulating cement to the top.
3. File completion forms ACO-1 with K.C.C. within 90 days of well completion, following instructions on ACO-1, side 1, and including copies of wireline logs.
4. Notify District office 48 hours prior to old well workover or re-entry.
5. Prior to plugging, prepare a plugging plan, then obtain agreement from the appropriate district office for an approved plugging plan.
6. Submit plugging report (CP-4) to K.C.C. after plugging is completed.
7. Obtain an approved injection docket number before disposing of salt water.
8. Notify K.C.C. within 10 days when injection commences or terminates.
9. If an alternate 2 completion, cement in the production pipe from below any usable water to surface within 120 days of spud date.

State Corporation Commission of Kansas
Conservation Division
200 Colorado Derby Building
Wichita, Kansas 67202
(316) 263-3238