

CARD MUST BE TYPED

State of Kansas
NOTICE OF INTENTION TO DRILL
(see rules on reverse side)

CARD MUST BE SIGNED

Starting Date: 9 7 85
month day year 2:20

OPERATOR: License # 4546
Name Paul Lamer, Inc.
Address 1225 W. Main, Ste. 122
City/State/Zip Norman, Oklahoma 73069
Contact Person Paul Lamer
Phone 405-360-1456

CONTRACTOR: License # 5302
Name Red Tiger Drilling Co.
City/State Wichita, Kansas 67202

Well Drilled For: Well Class: Type Equipment:
 Oil Swd Infield Mud Rotary
 Gas Inj Pool Ext. Air Rotary
 OWWO Expl Wildcat Cable

If OWWO: old well info as follows:
Operator
Well Name
Comp Date Old Total Depth
Projected Total Depth 4400 feet
Projected Formation at TD Miss
Expected Producing Formations Miss

API Number 15- 077-21,104-00-00
NW NW NE Sec 19 Twp 32S S, Rge 5W East
(location) West
4950 Ft North from Southeast Corner of Section
2310 Ft West from Southeast Corner of Section
(Note: Locate well on Section Plat on reverse side)

Nearest lease or unit boundary line 330 feet.
County Harper
Lease Name Rutledge Well# 1
Domestic well within 330 feet: yes no
Municipal well within one mile: yes no

Depth to Bottom of fresh water 40 feet
Lowest usable water formation
Depth to Bottom of usable water 220 feet
Surface pipe by Alternate: 1 2
Surface pipe to be set 250 feet
Conductor pipe if any required N/A feet
Ground surface elevation feet MSL.
This Authorization Expires 3-4-86
Approved By 9-4-85

I certify that we will comply with K.S.A. 55-101, et seq., plus eventually plugging hole to C.C. specifications.

Date 9/4/85 Signature of Operator or Agent *George A. Angle* Title Owner

BY RED TIGER DRILLING CO.

REH-SKONE

Must be filed with the K.C.C. five (5) days prior to commencing well
This card void if drilling not started within six (6) months of date received by K.C.C.

RECEIVED
STATE CORPORATION COMMISSION

09-04-1985


Important procedures to follow:

A Regular Section of Land
1 Mile = 5,280 Ft.

SEP 4 1985

CONSERVATION DIVISION

Wichita, Kansas

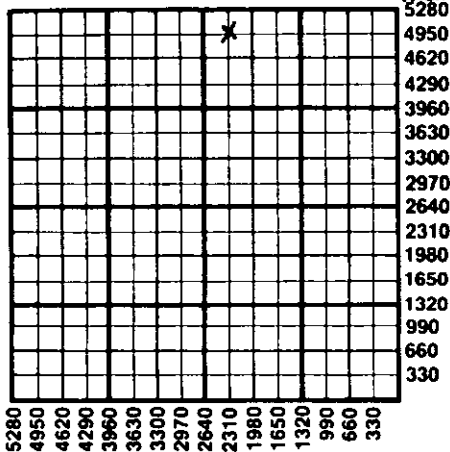

1. Notify District office before setting surface casing.
2. Set surface casing by circulating cement to the top.
3. File completion forms ACO-1 with K.C.C. within 90 days of well completion, following instructions on ACO-1, side 1, and including copies of wireline logs.
4. Notify District office 48 hours prior to old well workover or re-entry.
5. Prior to plugging, prepare a plugging plan, then obtain agreement from the appropriate district office for an approved plugging plan.
6. Submit plugging report (CP-4) to K.C.C. after plugging is completed.
7. Obtain an approved injection docket number before disposing of salt water.
8. Notify K.C.C. within 10 days when injection commences or terminates.
9. If an alternate 2 completion, cement in the production pipe from below any usable water to surface within 120 days of spud date.

State Corporation Commission of Kansas
Conservation Division
200 Colorado Derby Building
Wichita, Kansas 67202
(316) 263-3238