

CARD MUST BE TYPED

State of Kansas
NOTICE OF INTENTION TO DRILL
(see rules on reverse side)

CARD MUST BE SIGNED

Starting Date: May 31, 1985
month day year

API Number 15- 135-22,831.0000

OPERATOR: License # 9476
Glen Drotts dba

.SW. .SW. NW Sec .19. Twp .16. S, Rge .26. East
(location) West

Name G - D Oil Operations

Address P.O. Box 441

City/State/Zip Hays, KS 67601

Contact Person Glen Drotts

Phone 913-628-3560

.2970..... Ft North from Southeast Corner of Section
.4950..... Ft West from Southeast Corner of Section
(Note: Locate well on Section Plat on reverse side)

CONTRACTOR: License # 9087

Name R. & C. Drilling Co., Inc.

City/State Hays, Kansas

Nearest lease or unit boundary line 330 feet.
County Ness
Lease Name Horchem Well# 1

Well Drilled For: Well Class: Type Equipment:
 Oil Swd Infield Mod Rotary
 Gas Inj Pool Ext. Air Rotary
 OWWO Expl Wildcat Cable

Domestic well within 330 feet: yes no
Municipal well within one mile: yes no

If OWWO: old well info as follows:

Operator
Well Name
Comp Date Old Total Depth
Projected Total Depth 4560 feet
Projected Formation at TD Mississippi
Expected Producing Formations Mississippi

Depth to Bottom of fresh water 100 feet
Lowest usable water formation *Cherokee Dakota*
Depth to Bottom of usable water -900 1200 feet
Surface pipe by Alternate: 1 2
Surface pipe to be set 300 feet
Conductor pipe if any required NA feet
Ground surface elevation NA feet MSL
This Authorization Expires 11-28-85
Approved By 5-28-85 *R*

I certify that we will comply with K.S.A. 55-101, et seq., plus eventually plugging hole to K.C.C. specifications. Production string will be immediately cemented.

Date 5-23-85 Signature of Operator or Agent

R. F. Finney


Title Contractor
RCH for KCH
Form C-1 4/84

Wichita, Kansas
CONSERVATION DIVISION

Must be filed with the K.C.C. five (5) days prior to commencing well
This card void if drilling not started within six (6) months of date received by K.C.C.

RECEIVED
STATE CORPORATION COMMISSION
MAY 28 1985
MAY 28 1985

A Regular Section of Land
1 Mile = 5,280 Ft.

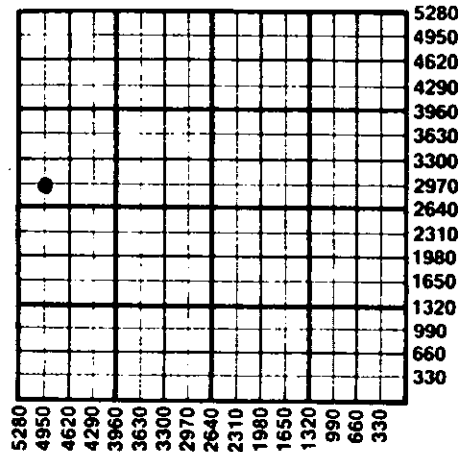

Important procedures to follow :

1. Notify District office before setting surface casing.
2. Set surface casing by circulating cement to the top.
3. File completion forms ACO-1 with K.C.C. within 90 days of well completion, following instructions on ACO-1, side 1, and including copies of wireline logs.
4. Notify District office 48 hours prior to old well workover or re-entry.
5. Prior to plugging, prepare a plugging plan, then obtain agreement from the appropriate district office for an approved plugging plan.
6. Submit plugging report (CP-4) to K.C.C. after plugging is completed.
7. Obtain an approved injection docket number before disposing of salt water.
8. Notify K.C.C. within 10 days when injection commences or terminates.
9. If an alternate 2 completion, cement in the production pipe from below any usable water to surface within 120 days of spud date.

State Corporation Commission of Kansas
Conservation Division
200 Colorado Derby Building
Wichita, Kansas 67202
(316) 263-3238