

15-077-19036-00-00

Form CP-4

STATE OF KANSAS  
STATE CORPORATION COMMISSION

WELL PLUGGING RECORD

Give All Information Completely  
Make Required Affidavit  
Mail or Deliver Report to:  
Conservation Division  
State Corporation Commission  
211 No. Broadway  
Wichita, Kansas

Harper County, Sec. 23 Twp. 32S Rge. 5W (XXX) (W)

Location as "NE/CNWxSWx" or footage from lines C SW NW

Lease Owner Nadel & Gussman and D. R. Lauck Oil Company, Inc.

Lease Name Wacker Well No. 1

Office Address 301 S. Broadway, Wichita, Kansas

Character of Well (completed as Oil, Gas or Dry Hole) Dry Hole

Date well completed September 17, 19 64

Application for plugging filed September 17, 19 64

Application for plugging approved September 17, 19 64


Plugging commenced September 17, 19 64

Plugging completed September 17, 19 64

Reason for abandonment of well or producing formation Dry Hole

If a producing well is abandoned, date of last production 19

Was permission obtained from the Conservation Division or its agents before plugging was commenced? Yes

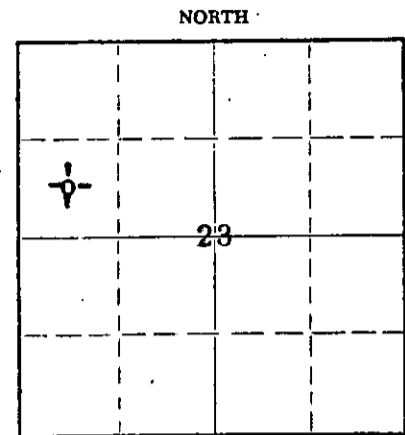

Locate well correctly on above Section Plat

Name of Conservation Agent who supervised plugging of this well Archie Elving

Producing formation Depth to top Bottom Total Depth of Well 4760 Feet

Show depth and thickness of all water, oil and gas formations.

OIL, GAS OR WATER RECORDS

CASING RECORD

FORMATION	CONTENT	FROM	TO	SIZE	PUT IN	PULLED OUT
		0'	226'	8-5/8"	226'	None

Describe in detail the manner in which the well was plugged, indicating where the mud fluid was placed and the method or methods used in introducing it into the hole. If cement or other plugs were used, state the character of same and depth placed, from feet to feet for each plug set.

4760'-220' Mud  
 220'-216' Plug  
 216'-176' Cement, 25 sx.  
 176'- 40' Mud  
 40'- 36' Plug  
 36'- 6' Cement, 10sx. (Bottom of Cellar)

RECEIVED  
STATE CORPORATION COMMISSION

OCT 12 1964  
10-12-1964  
CONSERVATION DIVISION  
Wichita, Kansas

(If additional description is necessary, use BACK of this sheet)

Name of Plugging Contractor Globe Cementing Co.

Address Great Bend, Kansas

STATE OF KANSAS, COUNTY OF SEDGWICK, ss.

John H. Knightley (employee of owner) or (owner or operator) of the above-described well, being first duly sworn on oath, says: That I have knowledge of the facts, statements, and matters herein contained and the log of the above-described well as filed and that the same are true and correct. So help me God.

(Signature) John H. Knightley  
301 S. Broadway, Wichita, Kansas  
(Address)

SUBSCRIBED AND SWORN TO before me this 9th day of October, 19 64

My commission expires March 12, 1967

Stella J. Lips Notary Public.

Nadel & Gussman and  
D. R. Lauck Oil Company, Inc.

15-077-19036-00-00

Wacker #1

C SW NW Sec. 23-32S-5W  
Harper County, Kansas

Commenced: August 31, 1964  
Completed: September 17, 1964

Casing Record: 226' 8-5/8" Cemented with 175 sacks Cement,  
4 sacks Calcium Chloride.

Elevation: 1274 GL; 1277 DF; 1279 KB.

RECEIVED  
STATE CORPORATION COMMISSION

OCT 12 1964  
10-12-1964  
CONSERVATION DIVISION  
Wichita, Kansas

Drillers Log

Tops

		Sample	Welex
Red Shale	200	Heebner	2960-1681
Red Bed & Shale	223	Toronto	2980-1701
Shale	530	Douglas	3003-1724
Shale & Lime	1100	Iatan	3317-2038
Lime & Shale	1500	Stalnaker	3341-2062
Shale & Lime	1610	Bonner Springs	3394-2115
Lime & Shale	1760	Kansas City	3588-2309
Shale	1995	Base Kansas City	3846-2567
Shale & Lime	2280	Marmaton	3901-2622
Lime & Shale	2397	Cherokee	4074-2795
Shale & Lime	3308	Mississippian	4261-2982
Lime & Shale	3398		
Shale & Sand	3523		
Shale & Lime	3622		
Lime	3725		
Lime & Shale	3776	DST #1 (W) 3757-77, Open 35 min. w/weak blow 7 min. Recovered 5' slightly oil-specked mud. ISIP 1460#/30 min. FSIP 330#/50 min. IFP 12#. FFP 20#.	
Lime	3845		
Shale & Lime	3935	DST #2 (W) 4263-85, Open 30 min., no blow. Recovered 2' mud. ISIP not taken. FSIP 47#, 30 min. FFP 21#.	
Lime	4140		
Lime & Shale	4285		
Lime	4300	DST #3 (W) 4723-30, Open 30 min. w/weak blow 6 min. Recovered 6' mud. ISIP 1873#/20 min. FSIP 1831#/ 20 min. IFP 21#. FFP 21#.	
Shale, Chert & Chalky Lime	4340		
Lime, Chert & Chalk	4380		
Lime	4420		
Lime, Shale, Chert	4464		
Lime, Chert	4478		
Lime	4568		
Lime & Chert	4613		
Shale & Lime	4717		
Sand & Shale	4760	RTD	D&A

I hereby certify that this is a true and correct  
log of the above mentioned well, to the best  
of my knowledge and belief.

*John B. Knightley*  
Subscribed and sworn to before me this

9<sup>th</sup> day of October 1964

*Stella J. Lipp*  
Notary Public

My commission expires 3-12-67