


Give All Information Completely
Make Required Affidavit
Mail or Deliver Report to:
Conservation Division
State Corporation Commission
211 No. Broadway
Wichita, Kansas

Harper County, Sec. 27 Twp. 31S Rge. 7 ~~X250X~~ (W)
Location as "NE/CNW/SW" or footage from lines C SE SW
Lease Owner Alva Oil Corporation, Inc.
Lease Name _____ Well No. 1
Office Address 510 Fourth National Bank Building, Wichita, Kansas
Character of Well (completed as Oil, Gas or Dry Hole) Dry Hole
Date well completed March 15 19 60
Application for plugging filed March 15 19 60
Application for plugging approved March 15 19 60
Plugging commenced March 15 19 60
Plugging completed March 15 19 60
Reason for abandonment of well or producing formation no oil and/or gas found
in commercial quantities
If a producing well is abandoned, date of last production _____ 19____
Was permission obtained from the Conservation Division or its agents before plugging was commenced? yes

NORTH

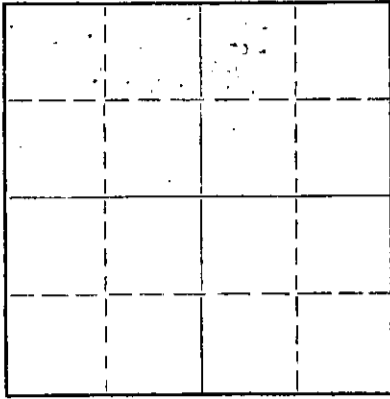

Locate well correctly on above
Section Plat

Name of Conservation Agent who supervised plugging of this well Fred Hampel
Producing formation _____ Depth to top _____ Bottom _____ Total Depth of Well 4800 Feet
Show depth and thickness of all water, oil and gas formations.

OIL, GAS OR WATER RECORDS

CASING RECORD

| FORMATION | CONTENT | FROM | TO | SIZE | PUT IN | PULLED OUT |
|-----------|---------|------|----|--------|--------|------------|
| | | | | 8-5/8" | 235' | |
| | | | | | | |
| | | | | | | |
Describe in detail the manner in which the well was plugged, indicating where the mud fluid was placed and the method or methods used in introducing it into the hole. If cement or other plugs were used, state the character of same and depth placed, from _____ feet to _____ feet for each plug set.

Filled hole with extra heavy rotary mud from total depth to 230'. Set Plug and 1/4 Sx. Hulls at 230' with 15 sacks cement. Filled hole with extra heavy rotary mud from Plug #1 to 40'. Set Plug & 1/4 sacks Hulls with 10 sacks cement. 2 sacks cement in rathole.

RECEIVED
STATE CORPORATION COMMISSION

APR 5 1960

CONSERVATION DIVISION
Wichita, Kansas

04-05-1960

(If additional description is necessary, use BACK of this sheet)


Name of Plugging Contractor Capitt Drilling, Inc.
Address 814 Union Center, Wichita, Kansas

STATE OF Kansas, COUNTY OF Sedgwick, ss.
R. R. McNicol (employee of owner) or (owner or operator) of the above-described well, being first duly sworn on oath, says: That I have knowledge of the facts, statements, and matters herein contained and the log of the above-described well as filed and that the same are true and correct. So help me God.

(Signature) R.R. McNicol
814 Union Center, Wichita, Kansas
(Address)

SUBSCRIBED AND SWORN TO before me this 17th day of March, 19 60

Darlene May
Darlene May Notary Public.

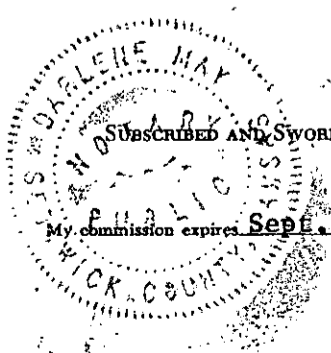

15-077-00072-00-00

ROTARY DRILLING LOG

OPERATOR: Alva Oil Corporation, Inc.
PEARL NO. 1
C SE SW Section 27-31S-7W,
Harper County, Kansas

CONTRACTOR: Capitt Drilling, Inc.
COMM: 2-28-60
COMP: 3-15-60

Formations:

Remarks: Set 8-5/8" casing at
235' cemented with
175 sacks cement

| | |
|--------------------------|-------|
| Surface hole | 236' |
| Lime & Shale | 250' |
| Lime & Shale Streaks | 715' |
| Shale w/Lime Streaks | 1240' |
| Shale & Lime | 1415' |
| Lime & Shale | 1584' |
| Lime | 1705' |
| Lime & Shale | 1806' |
| Lime | 2232' |
| Lime & Shale | 2360' |
| Shale & Lime | 2560' |
| Lime & Shale Streaks | 2800' |
| Shale & Shells | 2852' |
| Shale & Sand | 2956' |
| Shale w/Sand Streaks | 3230' |
| Lime w/Shale Streaks | 3447' |
| Lime & Shale | 3600' |
| Sand & Shale | 3719' |
| Shale & Lime | 3817' |
| Lime | 4074' |
| Lime & Shale Streaks | 4098' |
| Lime & Shale | 4248' |
| Shale & Lime | 4387' |
| Lime | 4410' |
| Chat & Chert | 4589' |
| Lime | 4656' |
| Shale & Sand | 4689' |
| Shale | 4782' |
| Sand & Shale | 4800' |
| Rotary Total Depth (D&A) | 4800' |

RECEIVED
STATE CORPORATION COMMISSION

APR 5 1960

CONSERVATION DIVISION
Wichita, Kansas

04-05-1960

We certify the above log is true and
correct to the best of our knowledge
and belief.

CAPITT DRILLING, INC.

R. R. McNicol

R. R. McNicol