

WELL PLUGGING RECORD

Give All Information Completely
Make Required Affidavit
Mail or Deliver Report to:
Conservation Division
State Corporation Commission
212 No. Market
Wichita, Kansas

Harper County, Sec. 28, Twp. 31, Rge. 7 (E) W (W)

Location as "NE/CNW/SW" or footage from lines (SW)NW, NW

Lease Owner Messman - Rinehart Oil Co.

Lease Name Hall Well No. #1

Office Address 1432 Wichita Plaza; Wichita, Ks. 67202

Character of Well (completed as Oil, Gas or Dry Hole) _____

Date well completed _____ 19 _____

Application for plugging filed June 19 70

Application for plugging approved June 19 70


Plugging commenced July 18 19 70

Plugging completed July 23 19 70

Reason for abandonment of well or producing formation _____

If a producing well is abandoned, date of last production _____ 19 _____

Was permission obtained from the Conservation Division or its agents before plugging was commenced? Yes

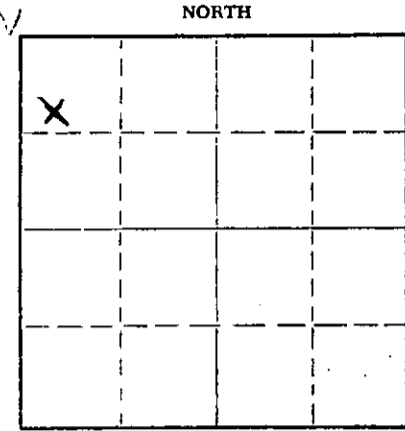

Locate well correctly on above Section Plat

Name of Conservation Agent who supervised plugging of this well Russell Biberstein

Producing formation _____ Depth to top _____ Bottom _____ Total Depth of Well _____ Feet

Show depth and thickness of all water, oil and gas formations.

OIL, GAS OR WATER RECORDS

CASING RECORD

FORMATION	CONTENT	FROM	TO	SIZE	PUT IN	PULLED OUT
				8 5/8	248	None
				5 1/2	4704	3290

Describe in detail the manner in which the well was plugged, indicating where the mud fluid was placed and the method or methods used in introducing it into the hole. If cement or other plugs were used, state the character of same and depth placed, from _____ feet to _____ feet for each plug set.

July 18, 1970 Plugged off bottom. Dumped sand to 4600'. Mixed and dumped 5 sx of cement to 4560'.

July 23, 1970 Plugged off top. Set 10' rock bridge from 230' to 240'. Filled 8 5/8" surface casing, from 230' to base of cellar, with 3000 lb. test ready-mix concrete.

RECEIVED
STATE CORPORATION COMMISSION
AUG 4 1970
CONSERVATION DIVISION
Wichita, Kansas
08-04-1970

(If additional description is necessary, use BACK of this sheet)
Name of Plugging Contractor RUSS CASING PULLING, INC.
Address P. O. BOX 1082; GREAT BEND, KANSAS 67530

STATE OF Kansas, COUNTY OF Sedgwick, ss.
J. A. Gilliland (employee of owner) or (owner or operator) of the above-described well, being first duly sworn on oath, says: That I have knowledge of the facts, statements, and matters herein contained and the log of the above-described well as filed and that the same are true and correct. So help me God.

(Signature) J. A. Gilliland
1432 Wichita Plaza, Wichita, Kansas
(Address)

SUBSCRIBED AND SWORN to before me this 3rd day of August, 1970
August 26, 1973
My commission expires _____
Arlene L. Sloop Notary Public.



15-077-10200-00-00

NO. 1 HALL

Well Record

Location: SW/4 NW/4 NW/4
 Sec. 28-31S-7W
 Harper County, Kansas

Operator: Messman-Rinehart Oil Company
 518 Petroleum Building
 Wichita, Kansas

Contractor: Messman-Rinehart Oil Company
 518 Petroleum Building
 Wichita, Kansas

Commenced: July 16, 1959
 Completed: August 3, 1959
 (rotary)
 Elevation: 1514' K/B
 Production: Oil

Casing Record: 8-5/8" @ 248' w/160 sx. cem.
 5-1/2" @ 4704' w/150 sx. cem.

*** LOG ***

Sand & Clay	30
Red Bed	125
Shale & Clay	195
Red Bed & Shale	225
Red Bed	248
Shale & Red Bed	500
Red Bed & Shale	1200
Anhydrite	1265
Shale w/streaks of anhy.	1285
Shale & Lime	1530
Lime & Shale	2790
Shale	2821
Shale	3000
Lime	3030
Lime & Shale	3870
Lime	3915
Lime	3950
Lime & Shale	4130
Lime	4176
Lime & Shale	4305
Shale	4317
Chert	4424
Chert & Lime	4480
Lime, Chalk & Chert	4530
Lime & Chert	4545
Lime & Shale	4565
Shale & Chalk	4620
Lime & Shale	4670
Shale	4678
Simpson Dolomite	4684
Dolomite	4704 R.T.D.

RECEIVED
 STATE CORPORATION COMMISSION
 AUG 4 1970
 CONSERVATION DIVISION
 Wichita, Kansas

08-04-1970

Sample Tops:

- 3254 - Heebner (-1740)
- 3808 - Lansing (-2294)
- 4316 - Mississippian (-2802)
- 4567 - Kinderhook (-3053)
- 4678 - Simpson (-3164)

The undersigned, MESSMAN-RINEHART OIL COMPANY, hereby certifies that the above log is a true and correct log of the formation encountered in drilling the above well as reflected by the Daily Drilling Reports.

MESSMAN-RINEHART OIL COMPANY

By: J. A. Gilliland
 J. A. Gilliland

Subscribed and sworn to before me
 this 20th day of August, 1959.

Barbara J. Scott
 Barbara J. Scott, Notary Public

My Commission Expires: December 1, 1960