

STATE OF KANSAS  
STATE CORPORATION COMMISSION

WELL PLUGGING RECORD

Give All Information Completely  
Make Required Affidavit  
Mail or Deliver Report to  
Conservation Division  
State Corporation Comm.  
245 North Water  
Wichita, KS 67202

Harper County. Sec. 25 Twp. 32S Rge. 6 X/W  
Location as "NE/CNW $\frac{1}{4}$ SW $\frac{1}{4}$ " or footage from lines  
C NE NW


Lease Owner Graves Drilling Co., Inc.  
Lease Name Mathes Well No. 1  
Office Address 910 Union Center, Wichita, Kansas 67202  
Character of Well (Completed as Oil, Gas or Dry Hole)  
Dry Hole

Date Well completed April 4 1979  
Application for plugging filed April 4 1979  
Application for plugging approved April 4 1979  
Plugging commenced April 4 1979  
Plugging completed April 4 1979  
Reason for abandonment of well or producing formation

If a producing well is abandoned, date of last production.  
19

Was permission obtained from the Conservation Division or  
its agents before plugging was commenced? Yes

Name of Conservation Agent who supervised plugging of this well William T. Owen, Pratt, KS  
Producing formation Depth to top Bottom Total Depth of Well 4439'  
Show depth and thickness of all water, oil and gas formations.

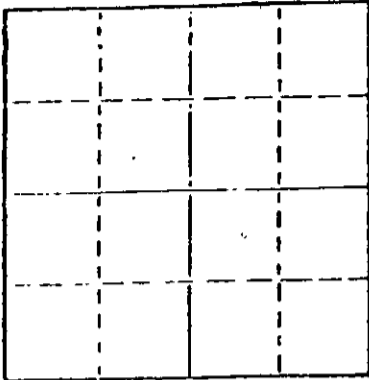

Locate well correctly on above  
Section Plot

OIL, GAS OR WATER RECORDS

CASING RECORD

FORMATION	CONTENT	FROM	TO	SIZE	PUT IN	PULLED OUT
				8-5/8"	211'	None

Describe in detail the manner in which the well was plugged, indicating where the mud fluid  
was placed and the method or methods used in introducing it into the hold. If cement or other  
plugs were used, state the character of same and depth placed, from feet to  
feet for each plug set.

Filled hole with heavy mud to 210'. Pumped 40 sacks of cement through drill pipe with  
pump truck. Pushed plug and 1/2 sack hulls to 40' and pumped 12 sacks of cement through  
drill pipe with pump truck to base of well cellar. Plugged rat hole with 2 sacks of cement.

RECEIVED  
STATE CORPORATION COMMISSION  
APR 16 1979  
04-16-1979  
CONSERVATION DIVISION  
Wichita, Kansas

(If additional description is necessary, use BACK of this sheet)

Name of Plugging Contractor Graves Drilling Co., Inc.  
910 Union Center, Wichita, Kansas

STATE OF KANSAS COUNTY OF SEDGWICK, ss.  
John C. Graves (employee of owner) or (owner or operator)  
of the above-described well, being first duly sworn on oath, says: That I have knowledge of  
the facts, statements, and matters herein contained and the log of the above-described well  
as filed and that the same are true and correct. So help me God.

(Signature) John C. Graves  
910 Union Center, Wichita, Kansas 67202  
(Address)

SUBSCRIBED AND SWORN TO before me this 13th day of April, 1979

Dorothy Gerber Notary Public.

My commission expires January 18, 1982



ROTARY DRILLERS LOG

OPERATOR: Graves Drilling Co., Inc.  
910 Union Center  
Wichita, Kansas 67202

DRILLING COMMENCED: March 26, 1979

CONTRACTOR: Graves Drilling Co., Inc.  
910 Union Center  
Wichita, Kansas 67202

DRILLING COMPLETED: April 4, 1979

CASING RECORD: 5 Jts. 211' of used 8-5/8"  
cemented with 185 sacks

LOCATION: MATHES NO. 1  
C NE NW  
Section 25-32S-6W  
Harper County, Kansas

---

0	-	211	Red Bed
211	-	944	Red Bed and Shale
944	-	1399	Shale and Lime
1399	-	1815	Lime and Shale
1815	-	2911	Shale and Lime
2911	-	3064	Shale
3064	-	3355	Shale and Lime
3355	-	3791	Lime and Shale
3791	-	4183	Shale and Lime
4183	-	4380	Lime and Shale
4380	-	4439	Lime
		4439	Rotary Total Depth

I hereby certify the foregoing statements to be true and correct to the best of my knowledge.


GRAVES DRILLING CO., INC.

By John Graves President

STATE OF KANSAS )  
                          ) SS.  
COUNTY OF SEDGWICK )

Subscribed and sworn to before me, a Notary Public, this 13th day of April, 1979.

Dorothy Gerber Notary Public

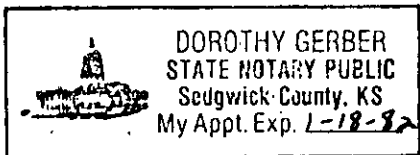

RECEIVED  
STATE CORPORATION COMMISSION

APR 16 1979  
04-16-1979  
CONSERVATION DIVISION  
Wichita, Kansas