


15-077-20375-00-00

STATE OF KANSAS
STATE CORPORATION COMMISSION
CONSERVATION DIVISION
P. O. BOX 17027
WICHITA, KANSAS 67217

FORM CP-4

WELL PLUGGING RECORD

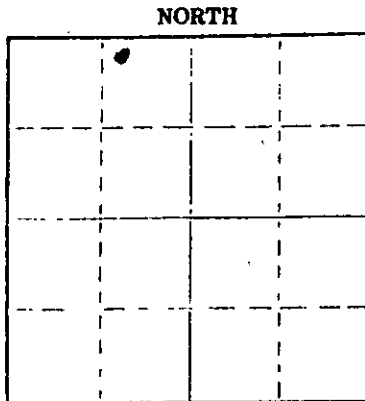

Locate well correctly on above Section Plat

Harper County, Sec 32 Twp. 32S Rge. 6 (E) W (W)
Location as "NE/CNW/SE/SW" or footage from lines NW NE NW
Lease Owner Lee Phillips Oil Co.
Lease Name Terrell Well No. 1
Office Address 125 N. Market, Suite 1532, Wichita, Kansas 67202
Character of Well (completed as Oil, Gas or Dry Hole) D & A
Date well completed 8-18 1976
Application for plugging filed 8-18 1976
Application for plugging approved 8-18 1976
Plugging commenced 8-18 1976
Plugging completed 8-18 1976
Reason for abandonment of well or producing formation D & A

If a producing well is abandoned, date of last production 19
Was permission obtained from the Conservation Division or its agents before plugging was commenced? Yes

Name of Conservation Agent who supervised plugging of this well Russ Bieberstien
Producing formation _____ Depth to top _____ Bottom _____ Total Depth of Well _____
Show depth and thickness of all water, oil and gas formations

OIL, GAS OR WATER RECORDS CASING RECORD

FORMATION	CONTENT	FROM	TO	SIZE	PUT IN	PULLED OUT
Surface pipe		-0-	240	8 5/8"	240	None

Describe in detail the manner in which the well was plugged, indicating where the mud fluid was placed and the method or methods used in introducing it into the hole. If cement or other plugs were used, state the character of same and depth placed, from _____ feet to _____ feet for each plug set.

Filled hole with heavy mud.
#1 Plug set @ 250' with 35 sks. cement.
#2 Plug set @ 40' with 15 sks. cement.
#3 plug set in rat hole with 5 sks. cement.

Name of Plugging Contractor Sweetman Drilling, Inc. (If additional description is necessary, use BACK of this sheet)
Address Box 645, Great Bend, Kansas 67530


STATE OF Kansas COUNTY OF Barton ss.
Gary L. Hawk (employee of owner) or (owner/contractor) of the above-described

well, being first duly sworn on oath, says: That I have knowledge of the facts, statements, and matters herein contained and the log of the above-described well as filed and that the same are true and correct. So help me God.

(Signature) Gary L. Hawk
Box 645, Great Bend, Kansas 67530
(Address)

SUBSCRIBED AND SWORN TO before me this 23rd day of August, 1976

My commission expires 7-10-77
Mary Ann Schwabson Notary Public.

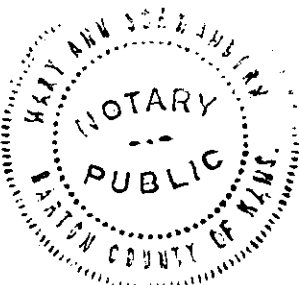

15-077-20375-00-00

WELL LOG
Terrell #1
NW NE NW 32-32S-6W
Harper County, Kansas

Name of Operator: Lee Phillips Oil Co.
125 N. Market, Suite 1532
Wichita, Kansas 67202

Date Completed: August 19, 1976

<u>FROM</u>	<u>TO</u>	
0	1115	Red bed and shale
1115	3561	Shale and lime
3561	3637	S-Sand
3637	4064	Lime and shale
4064	4856	Lime
4856		Total Depth

STATE OF KANSAS

COUNTY OF BARTON ss

RECEIVED
STATE CORPORATION COMMISSION
AUG 24 1976
CONSERVATION DIVISION
Wichita, Kansas
08-24-1976

Gary L. Hawk, Secretary of Sweetman Drilling, Inc., being first duly sworn on oath says: That I have knowledge of the facts, statements and matters herein contained and the log of the above described well as filed and that the same are true and correct.

Gary L. Hawk
Gary L. Hawk

Subscribed and sworn before me this 23rd day of August, 1976.

Mary Ann Schwamborn
Notary Public Barton County

My Commission Expires 7-10-77

