


Give All Information Completely  
Make Required Affidavit  
Mail or Deliver Report to:  
Conservation Division  
State Corporation Commission  
212 No. Market  
Wichita, Kansas

WELL PLUGGING RECORD

Harper County, Sec. 31 Twp. 32S Rge. 6 (E) W (W)  
Location as "NE/CNW%SW%" or footage from lines NW SE  
Lease Owner Deck Oil Co.  
Lease Name Williams Well No. 1  
Office Address 2702 Fourth Natl. Bank Bldg., Tulsa, Oklahoma 74101  
Character of Well (completed as Oil, Gas or Dry Hole) Dry Hole  
Date well completed 2-8 19 70  
Application for plugging filed 2-8 19 70  
Application for plugging approved 2-8 19 70  
Plugging commenced 2-8 19 70  
Plugging completed 2-8 19 70  
Reason for abandonment of well or producing formation Dry Hole

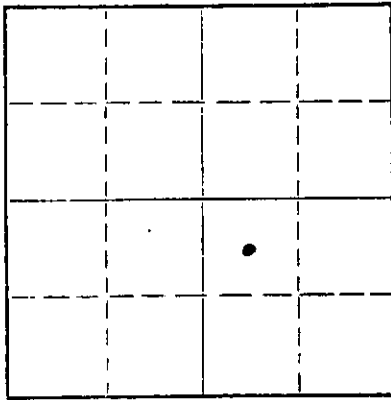

Locate well correctly on above Section Plat

If a producing well is abandoned, date of last production 19  
Was permission obtained from the Conservation Division or its agents before plugging was commenced? Yes

Name of Conservation Agent who supervised plugging of this well Russ Bihenstein  
Producing formation \_\_\_\_\_ Depth to top \_\_\_\_\_ Bottom \_\_\_\_\_ Total Depth of Well \_\_\_\_\_ Feet  
Show depth and thickness of all water, oil and gas formations.

OIL, GAS OR WATER RECORDS

CASING RECORD

FORMATION	CONTENT	FROM	TO	SIZE	PUT IN	PULLED OUT
Surface pipe		-0-	292	8 5/8"	292	None

Describe in detail the manner in which the well was plugged, indicating where the mud fluid was placed and the method or methods used in introducing it into the hole. If cement or other plugs were used, state the character of same and depth placed, from \_\_\_\_\_ feet to \_\_\_\_\_ feet for each plug set.

Filled hole with heavy mud.  
#1 plug set @ 275' with 25 sks. cement.  
#2 plug set @ 40' with 10 sks. cement.  
#3 plug in rat hole with 2 sks. cement.

RECEIVED  
STATE CORPORATION COMMISSION  
FEB 12 1970  
CONSERVATION DIVISION  
Wichita, Kansas

02-12-1970

(If additional description is necessary, use BACK of this sheet)

Name of Plugging Contractor Sweetman Drilling, Inc.  
Address Box 645, Great Bend, Kansas 67530

STATE OF Kansas, COUNTY OF Barton, ss.  
T. D. Sweetman (employee of owner) or (owner or operator) of the above-described

well being first duly sworn on oath, says: That I have knowledge of the facts, statements, and matters herein contained and the log of the above-described well as filed and that the same are true and correct. So help me God.


(Signature) T. D. Sweetman

Box 645, Great Bend, Kansas 67530  
(Address)

SUBSCRIBED AND SWORN TO before me this 10th day of February, 1970

Mary Ann Schwaborn  
Notary Public.

My commission expires 7-10-73

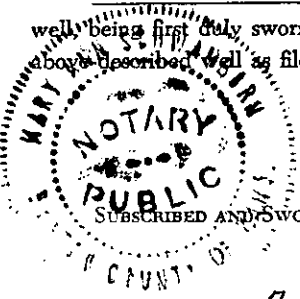

15-077-20096-00-00

WELL LOG  
Williams #1  
NW SE 31-32S-6W  
Harper County, Kansas

Operator: Deck Oil Co.  
2702 Fourth Natl. Bank Bldg.  
Tulsa, Oklahoma 74101

Date Completed: 2-9-70

<u>FROM</u>	<u>TO</u>	
0	620	Red bed & shale
620	1315	Shale and shells
1315	3920	Lime & shale
3920	4452	Lime
4452	4710	Miss.
4710	4842	Lime
4842	4861	Sand
4861		Total Depth

RECEIVED  
STATE CORPORATION COMMISSION  
FEB 12 1970  
CONSERVATION DIVISION  
Wichita, Kansas  
02-12-1970

STATE OF KANSAS

COUNTY OF BARTON ss

T. D. Sweetman, President of Sweetman Drilling, Inc., being first duly sworn on oath says: That I have knowledge of the facts, statements and matters herein contained and the log of the above described well as filed and that the same are true and correct.

T. D. Sweetman  
T. D. Sweetman

Subscribed and sworn before me this 10th day of February, 1970.

Mary Ann Schwaborn  
Notary Public Barton County

My Commission Expires 7-10-73

