


STATE OF KANSAS
STATE CORPORATION COMMISSION

15-077-20174-00-00 Form CP-4

WELL PLUGGING RECORD

Give All Information Completely
Make Required Affidavit
Mail or Deliver Report to:
Conservation Division
State Corporation Commission
P. O. Box 17027
Wichita, Kansas 67217

Harper County, Sec. 31 Twp. 32S Rge. 6-W (E) (W)
Location as "NE/CNW/ESW" or footage from lines NW NW SE
Lease Owner McCoy Petroleum Co.
Lease Name Williams Well No. 1
Office Address 816 Vickers KSB&T Bldg.
Character of Well (completed as Oil, Gas or Dry Hole) gas
Date well completed 5-30 1973
Application for plugging filed August 1976
Application for plugging approved 8-27 1976
Plugging commenced 10-3- 1976
Plugging completed 10-8 1976
Reason for abandonment of well or producing formation Gas Depleted

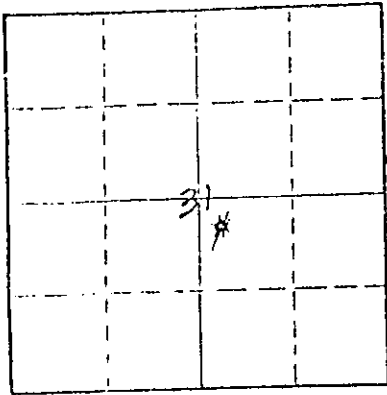

Locate well correctly on above Section Plot

If a producing well is abandoned, date of last production September 1975
Was permission obtained from the Conservation Division or its agents before plugging was commenced? Yes

Name of Conservation Agent who supervised plugging of this well Russell Biberstien
Producing formation Mississippian Depth to top 4435 Bottom 4457 Total Depth of Well 4457 Feet
Show depth and thickness of all water, oil and gas formations.

OIL, GAS OR WATER RECORDS

CASING RECORD

FORMATION	CONTENT	FROM	TO	SIZE	PUT IN	PULLED OUT
Mississippian	Gas	4435		8 5/8 4 1/2	267 4440	None 3826

Describe in detail the manner in which the well was plugged, indicating where the mud fluid was placed and the method or methods used in introducing it into the hole. If cement or other plugs were used, state the character of same and depth placed, from feet to feet for each plug set.

Sand from 4457' to 4400'
4 sacks cement from 4400' to 4370'
Ripped at 4000' - 3900' - 3826'
Wooden bridge at 340'
Rock from 340' to 330'
5 yards ready mix to surface.

RECEIVED
OCT 06 1976
CONSERVATION DIVISION
Wichita, Kansas

12-06-1976

(If additional description is necessary, use BACK of this sheet)
Name of Plugging Contractor Clarke Corporation
Address Box 187, Medicine Lodge, Kansas 67104

STATE OF KANSAS, COUNTY OF SEDGWICK, ss.
John Roger McCoy (owner or operator) of the above-described

well, being first duly sworn on oath, says: That I have knowledge of the facts, statements, and matters herein contained and the log of the above-described well as filed and that the same are true and correct. So help me God.

(Signature) John Roger McCoy
816 Vickers-KSB&T Bldg., Wichita, Kansas
(Address)

Subscribed and sworn to before me this 18th day of October, 1976

Christina Louise Duncan
Notary Public.

My commission expires February 20, 1978

Christina Louise Duncan
NOTARY PUBLIC
SEDGWICK COUNTY, KANSAS
MY COMM. EXP. FEB. 20, 1978

WELL LOG
Williams #1
NW NW SE 31-32S-6W
Harper County, Kansas

15-077-20174-00-00

Name of Operator: McCoy Petroleum Co.
502 Union Center Bldg.
Wichita, Kansas 67202

Date Completed: January 11, 1973

<u>FROM</u>	<u>TO</u>	
0	484	Red bed and shale
484	1100	Shale
1100	3900	Shale and lime
3900	4460	Lime
4460		Total Depth


RECEIVED
STATE CONSERVATION COMMISSION

DEC 06 1976
12-06-1976
CONSERVATION DIVISION
Wichita, Kansas

STATE OF KANSAS

COUNTY OF BARTON ss

Gary L. Hawk, Secretary of Sweetman Drilling, Inc., being first duly sworn on oath says: That I have knowledge of the facts, statements and matters herein contained and the log of the above described well as filed and that the same are true and correct.

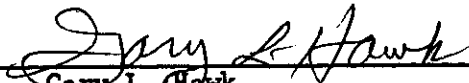

Gary L. Hawk

Subscribed and sworn before me this 4th day of April, 1973.



Notary Public Barton County

My Commission expires 7-10-73

