


Give All Information Completely
Make Required Affidavit
Mail or Deliver Report to:
Conservation Division
State Corporation Commission
P. O. Box 17027
Wichita, Kansas 67217
NORTH

WELL PLUGGING RECORD

Harper County, Sec. 31 Twp. 32 Rge. 6 (E) W (W)
Location as "NE/CNW/SW" or footage from lines NW SW NE.
Lease Owner McCoy Petroleum Company
Lease Name Prouse Well No. 1
Office Address 502 Union Center Bldg., Wichita, Kansas 67202
Character of Well (completed as Oil, Gas or Dry Hole) Dry Hole
Date well completed 1-4 19 74
Application for plugging filed 1-4 19 74
Application for plugging approved 1-4 19 74
Plugging commenced 1-4 19 74
Plugging completed 1-4 19 74
Reason for abandonment of well or producing formation Dry Hole
If a producing well is abandoned, date of last production 19
Was permission obtained from the Conservation Division or its agents before plugging was commenced? Yes

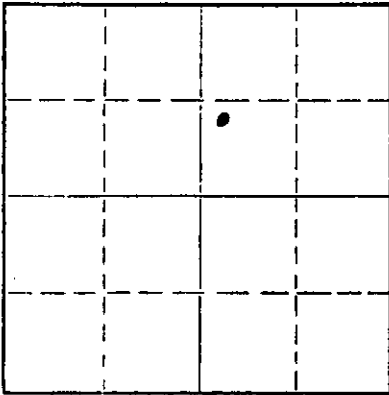

Locate well correctly on above Section Plat

Name of Conservation Agent who supervised plugging of this well Russ Biberstein
Producing formation _____ Depth to top _____ Bottom _____ Total Depth of Well _____ Feet
Show depth and thickness of all water, oil and gas formations.

OIL, GAS OR WATER RECORDS

CASING RECORD

FORMATION	CONTENT	FROM	TO	SIZE	PUT IN	PULLED OUT
Surface pipe		-0-	226	8 5/8"	226	None

Describe in detail the manner in which the well was plugged, indicating where the mud fluid was placed and the method or methods used in introducing it into the hole. If cement or other plugs were used, state the character of same and depth placed, from _____ feet to _____ feet for each plug set.

- Filled hole with heavy mud.
- #1 Plug set @ 200' with 25 sks. cement.
- #2 Plug set @ 40' with 10 sks. cement.
- #3 Plug set in rat hole with 2 sks. cement.

RECEIVED
STATE CORPORATION COMMISSION
JAN 11 1974
CONSERVATION DIVISION
Wichita, Kansas
01-11-1974

(If additional description is necessary, use BACK of this sheet)
Name of Plugging Contractor Sweetman Drilling, Inc.
Address P.O. Box 645, Great Bend, Kansas 67530

STATE OF Kansas, COUNTY OF Barton, ss.
Gary L. Hawk (employee of owner) or (owner/operator) of the above-described well, being first duly sworn on oath, says: That I have knowledge of the facts, statements, and matters herein contained and the log of the above-described well as filed and that the same are true and correct. So help me God.

(Signature) Gary L. Hawk
Box 645, Great Bend, Kansas 67530
(Address)

SUBSCRIBED AND SWORN to before me this 10th day of January, 1973
Mary Ann Schwamborn
Notary Public.



15-077-20233-00-00

WELL LOG
Prouse #1
NW SW NE 31-32S-6W
Harper County, Kansas

Name of Operator: McCoy Petroleum Company
502 Union Center Bldg.
Wichita, Kansas 67202

Date Completed: January 4, 1974

FROM	TO	
0	228	Red bed and shale
228	1114	Shale
1114	3575	Shale and lime
3575	3697	Stalnaker
3697	3930	Lime and shale
3930	4475	Lime
4475	4495	Miss.
4495		Total Depth

RECEIVED
STATE CORPORATION COMMISSION
JAN 11 1974
CONSERVATION DIVISION
Wichita, Kansas
01-11-1974

STATE OF KANSAS

COUNTY OF BARTON ss

Gary L. Hawk, Secretary of Sweetman Drilling, Inc., being first duly sworn on oath says: That I have knowledge of the facts, statements and matters herein contained and the log of the above described well as filed and that the same are true and correct.

Gary L. Hawk
Gary L. Hawk

Subscribed and sworn before me this 10th day of January, 1974.

Mary Ann Schwaborn
Notary Public Barton County

My Commission Expires 7-10-77

