


15-077-3009-00-00

WELL PLUGGING RECORD

Give All Information Completely
Make Required Affidavit
Mail or Deliver Report to:
Conservation Division
State Corporation Commission
211 No. Broadway
Wichita, Kansas

Harper County, Sec. 28 Twp. 32S Rge. (E) 6 (W)

Location as "NE/CNW/SW" or footage from lines Ctr. SW SW
Lease Owner Graybol Oil Corporation
Lease Name Parsons Well No. 1
Office Address 2200 N.B.T. Bldg, Tulsa, Okla. 74103
Character of Well (completed as Oil, Gas or Dry Hole) Dry Hole
Date well completed July 23 19 65
Application for plugging filed July 23 19 65
Application for plugging approved July 23 19 65
Plugging commenced July 23 19 65
Plugging completed July 23 19 65
Reason for abandonment of well or producing formation _____

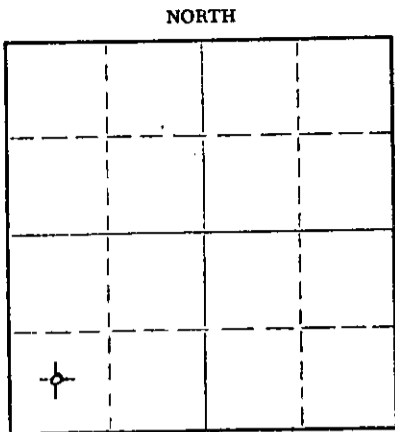

Locate well correctly on above
Section Plat

If a producing well is abandoned, date of last production _____ 19 _____
Was permission obtained from the Conservation Division or its agents before plugging was commenced? Yes

Name of Conservation Agent who supervised plugging of this well Archie Elving
Producing formation None Depth to top _____ Bottom _____ Total Depth of Well 4886 Feet
Show depth and thickness of all water, oil and gas formations.

OIL, GAS OR WATER RECORDS

CASING RECORD

FORMATION	CONTENT	FROM	TO	SIZE	PUT IN	PULLED OUT
Stalnaker sand	Water	3609	3636	8 5/8"	223'	None
Kansas City	Impermeable	3839	4073			
Mississippian	Impermeable	4444	4755			
Simpson sand	Water	4872	4886			

Describe in detail the manner in which the well was plugged, indicating where the mud fluid was placed and the method or methods used in introducing it into the hole. If cement or other plugs were used, state the character of same and depth placed, from _____ feet to _____ feet for each plug set.

Filled hole with heavy mud-laden fluid to 220'. Inserted 1/4 sack of hulls, then Halliburton plug. Cemented with 25 sacks of regular cement. Filled hole with heavy mud-laden fluid to 40'. Inserted 1/4 sack of hulls and Halliburton plug. Cemented with ten sacks of regular cement, filling hole to surface. Placed two sacks of regular cement in rat-hole.

RECEIVED
STATE CORPORATION COMMISSION
07-27-1965
JUL 27 1965

CONSERVATION DIVISION
Wichita, Kansas

(If additional description is necessary, use BACK of this sheet)
Name of Plugging Contractor Graybol Oil Corporation
Address as above

STATE OF OKLAHOMA, COUNTY OF TULSA, ss.
Lyman C. Dennis (employee of owner) or (owner-or-operator) of the above-described well, being first duly sworn on oath, says: That I have knowledge of the facts, statements, and matters herein contained and the log of the above-described well as filed and that the same are true and correct. So help me God.

(Signature) Lyman C. Dennis
Tulsa, Oklahoma
(Address)

SUBSCRIBED AND SWORN TO before me this 26th day of July, 19 65

[Signature]
Notary Public.

My commission expires October 2, 1967

GRAYBOL OIL CORPORATION

Harper County, Kansas

No. 1 Parsons

Ctr. SW SW Sec. 28-32S-6W

Contractor: Company Tools

Elev: 1399 K.B. & D.F., 1393 G.L.

Commenced: July 7, 1965

Completed: July 23, 1965

Production: Dry and Abandoned

CASING RECORD

8 5/8" surface casing set at 223' with 150 sacks pozmix cement.

DEPTH	FORMATION	WELEX ELECTROLOG TOPS:	
0-37	Red shale	Heebner shale	3247 (-1848)
37-225	Red shale and shells	Stalnaker sand	3609 (-2210)
225-760	Red bed and shale	Kansas City	3839 (-2440)
760-1288	Shale and shells	Base of Kansas City	4073 (-2674)
1288-1745	Lime and shale	Mississippian	4444 (-3045)
1745-1820	Lime	Kinderhook shale	4755 (-3356)
1820-2200	Lime and shale	Chattanooga shale	4849 (-3459)
2200-2580	Shale and lime	Viola absent	
2580-3043	Lime and shale	Simpson sand	4872 (-3473)
3043-3197	Lime, shale and sand	Welex Total Depth	4885
3197-3855	Lime and shale		
3855-3931	Lime	No cores or drill stem tests taken.	
3931-3965	Chert and lime		
3965-4224	Lime		
4224-4280	Lime and shale		
4280-4415	Lime		
4415-4461	Lime and shale		
4461-4486	Chert and lime		
4486-4535	Lime and chert		
4535-4585	Chert and lime		
4585-4753	Lime and chert		
4753-4809	Shale and lime		
4809-4860	Lime and shale		
4860-4886	Lime, shale and sand		
4886	Driller's Total Depth		

RECEIVED
STATE CORPORATION COMMISSION
JUL 27 1965
07-27-1965
CONSERVATION DIVISION
Wichita, Kansas

I hereby certify that the above is a true and correct log of the above-captioned test as taken directly from the daily drilling reports.

GRAYBOL OIL CORPORATION

BY: Lyman C. Dennis
Lyman C. Dennis, Geologist

STATE OF OKLAHOMA

COUNTY OF TULSA

Subscribed and sworn to this 26th day of July, 1965.

My Commission expires: October 2, 1967

James J. Miller
NOTARY PUBLIC