


WELL PLUGGING RECORD

Give All Information Completely
Make Required Affidavit
Mail or Deliver Report to:
Conservation Division
State Corporation Commission
211 No. Broadway
Wichita, Kansas

Harper County. Sec. 23 Twp. 32S Rge. 7W (E) (W)
Location as "NE/CNWxSWx" or footage from lines 330-SL. 33 WL
Lease Owner Home-Stake Production Company
Lease Name Miller Well No. A-1
Office Address Philtower Building, Tulsa, Oklahoma
Character of Well (completed as Oil, Gas or Dry Hole) Dry Hole
Date well completed August 3, 19 57
Application for plugging filed August 3, 19 57
Application for plugging approved August 3, 19 57
Plugging commenced August 3, 19 57
Plugging completed August 3, 19 57
Reason for abandonment of well or producing formation Dry Hole

NORTH

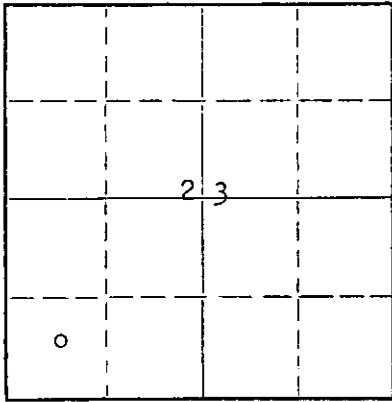

Locate well correctly on above Section Plat

If a producing well is abandoned, date of last production _____ 19 ____
Was permission obtained from the Conservation Division or its agents before plugging was commenced? Yes

Name of Conservation Agent who supervised plugging of this well Merl Rieves
Producing formation None Depth to top _____ Bottom _____ Total Depth of Well 1964 Feet
Show depth and thickness of all water, oil and gas formations.

OIL, GAS OR WATER RECORDS

CASING RECORD

FORMATION	CONTENT	FROM	TO	SIZE	PUT IN	PULLED OUT

Describe in detail the manner in which the well was plugged, indicating where the mud fluid was placed and the method or methods used in introducing it into the hole. If cement or other plugs were used, state the character of same and depth placed, from _____ feet to _____ feet for each plug set.

Filled hole with heavy mud. Bridged hole at 255 feet. Cemented with 20 sacks of cement. Filled hole to 35 feet with heavy mud. Bridged hole at 35 feet. Filled to top with 10 sacks of cement.

STATE CORPORATION COMMISSION
WICHITA, KANSAS
AUG 10 1957
CONSERVATION DIVISION

(If additional description is necessary, use BACK of this sheet)
Name of Plugging Contractor Gene Walker, Inc., Drilling Tool Division
Address Box 64, Great Bend, Kansas

STATE OF Kansas, COUNTY OF Barton, ss.
_____(employee of owner) or (owner or operator) of the above-described well, being first duly sworn on oath, says: That I have knowledge of the facts, statements, and matters herein contained and the log of the above-described well as filed and that the same are true and correct. So help me God.

(Signature) Home - Stake Production Co
S. K. Brumwell
(Address)

SUBSCRIBED AND SWORN TO before me this 7th day of August, 19 57

My commission expires 4-11-59

John W. [Signature]
Notary Public.

PLUGGING
FILE SEC 23 T 32 R 7W
BOOK PAGE 34 LINE 12

15-077-00171-00-00

Home-Stake Production Company
Miller A-1

SW-SW-NW Sec. 23-32S-7W
Harper County, Kansas
Elevation: 1401 D.F.
Contractor: Gene Walker, Inc.

Total Depth: 4964
Commenced: 7-12-57
Completed: 8-3-57

Strata	Depth
Red Bed & Shells.	0- 262
Red Bed	262- 410
Shale & Shells	410- 1102
Lime & Shale	1102- 1658
Shale	1658- 1770
Lime	1770- 1888
Lime & Shale	1888- 2348
Shale	2348- 2653
Lime & Shale	2653- 2864
Shale	2864- 3215
Lime & Shale	3215- 3449
Lime	3449- 3522
Lime & Sand	3522- 3737
Shale	3737-3773
Lime	3773- 4250
Lime & Shale	4250- 4383
Lime	4383- 4510
Cherty Lime	4510- 4585
Lime	4585- 4649
Shale	4649- 4771
Sand	4771- 4782
Sand	4782- 4915
Sand & Shale	4915- 4935
Sand	4935- 4949
Lime	4949- 4964

I hereby certify the above a true and correct log as reflected by the Daily Drilling Reports of Gene Walker, Inc.

By S. A. Berwick
S. A. Berwick, President

Signed and sworn to in my presence this 9th day of August, 1957
by S. A. Berwick, President of Gene Walker, Inc.

[Signature]
NOTARY PUBLIC

My Commission Expires: My Commission Expires June 22, 1959

PLUGGING
FILE SEC. 23 T. 32 R. 7W.
BOOK PAGE 34 LINE 12

ST. LOUIS
GEOLOGICAL DIVISION
Wichita, Kansas

08-10-1957