


STATE OF KANSAS  
STATE CORPORATION COMMISSION

Give All Information Completely  
Make Required Affidavit  
Mail or Deliver Report to:  
Conservation Division  
State Corporation Commission  
212 No. Market  
Wichita, Kansas

15-077-00201-00-01 Form CP-4  
WELL PLUGGING RECORD

NORTH

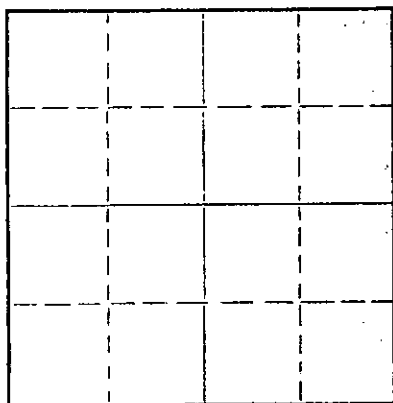

Locate well correctly on above  
Section Plat

Harper County. Sec. 22 Twp. 32S Rge. (E) 7(W)  
Location as "NE/CNWxSWx" or footage from lines NE NE NE  
Lease Owner K & E Drilling, Inc.  
Lease Name WEIGLE Well No. 1  
Office Address 816 Union Center, Wichita, Kansas  
Character of Well (completed as Oil, Gas or Dry Hole) dry hole  
Date well completed 8-27-70 19  
Application for plugging filed 8-27-70 19  
Application for plugging approved verbal 8-27-70 19  
Plugging commenced 8-27-70 19  
Plugging completed 8-27-70 @ 3:00 a.m. 19  
Reason for abandonment of well or producing formation DRY

If a producing well is abandoned, date of last production 19  
Was permission obtained from the Conservation Division or its agents before plugging was commenced? yes. verbal

Name of Conservation Agent who supervised plugging of this well G. Russell Biberstein  
Producing formation Depth to top Bottom Total Depth of Well 3296.3 Feet  
Show depth and thickness of all water, oil and gas formations.

OIL, GAS OR WATER RECORDS

CASING RECORD

FORMATION	CONTENT	FROM	TO	SIZE	PUT IN	PULLED OUT
				8-5/8	271'	--0--
				(Set by CRA)		

Describe in detail the manner in which the well was plugged, indicating where the mud fluid was placed and the method or methods used in introducing it into the hole. If cement or other plugs were used, state the character of same and depth placed, from feet to feet for each plug set.

Plug & 2 sx. hulls @ 265', 25 sx. cement.  
Plug & 2 sx. hulls @ 40', 10 sx. cement to surface.  
2 sx. cement in rat. hole.

This was OWWO of CRA #1 Weigle "B" drilled in November 1958.

RECEIVED  
STATE CORPORATION COMMISSION  
AUG 28 1970  
CONSERVATION DIVISION  
Wichita, Kansas  
08-28-1970

(If additional description is necessary, use BACK of this sheet)  
Name of Plugging Contractor Graves Drilling Co., Inc.  
Address 505 Union Center, Wichita, Kansas 67202

STATE OF Kansas, COUNTY OF Sedgwick, ss.  
Wayne L. Brinegar (employee of owner) or (owner or operator) of the above-described well, being first duly sworn on oath, says: That I have knowledge of the facts, statements, and matters herein contained and the log of the above-described well as filed and that the same are true and correct. So help me God.

(Signature) Wayne L. Brinegar  
Wayne L. Brinegar  
816 Union Center, Wichita, Kansas 67202  
(Address)

SUBSCRIBED AND SWORN TO before me this 27th day of August, 1970

My commission expires 8-30-73

Julene M. Bannon  
Julene M. Bannon Notary Public.