


STATE OF KANSAS
STATE CORPORATION COMMISSION

Give All Information Completely
Make Required Affidavit
Mail or Deliver Report to:
Conservation Division
State Corporation Commission
800 Bitting Building
Wichita, Kansas

OR
FORMATION PLUGGING RECORD

Strike out upper line
when reporting plug-
ging off formations.

Harper County. Sec. 21 Twp 32S Rge. 7 (W)
Location as "NE1/4NW1/4SW1/4" or footage from lines 330' SNL, 330' WEL, NE/4
Lease Owner Gulf Oil Corporation
Lease Name F. E. Dent Well No. 1
Office Address Box 661, Tulsa, Oklahoma
Character of Well (completed as Oil, Gas or Dry Hole) Dry Hole
Date well completed July 28, 1949
Application for plugging filed August 2, 1949
Application for plugging approved August 2, 1949
Plugging commenced August 2, 1949
Plugging completed August 4, 1949
Reason for abandonment of well or producing formation Dry Hole

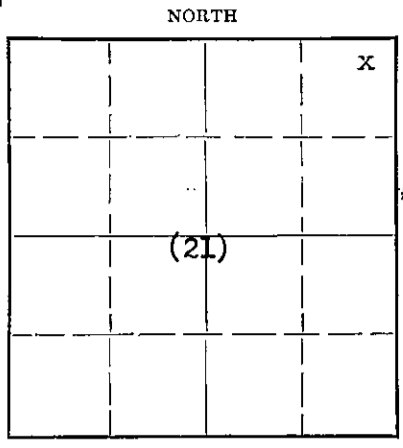

Locate well correctly on above Section Plat

If a producing well is abandoned, date of last production - 19
Was permission obtained from the Conservation Division or its agents before plugging was commenced? Yes
Name of Conservation Agent who supervised plugging of this well Mr. Ruel Durkee
Producing formation Arbuckle Depth to top 4916' Bottom 5050' Total Depth of Well 5050' Feet
Show depth and thickness of all water, oil and gas formations.

OIL, GAS OR WATER RECORDS

CASING RECORD

Formation	Content	From	To	Size	Put In	Pulled Out
				13-3/8"	1210'	None

Describe in detail the manner in which the well was plugged, indicating where the mud fluid was placed and the method or methods used in introducing it into the hole. If cement or other plugs were used, state the character of same and depth placed, from feet to feet for each plug set.

Circulated hole to 2517' with 13# mud, bridged with HOWCO plug at 300'. Spotted 25 sacks cement 250'-230'. Bridged at 12' with HOWCO plug. Filled to top with 20 sacks cement.

REC'D
FILED
AUG 23 1949
STATE OF KANSAS
COMMISSIONER

(If additional description is necessary, use BACK of this sheet)

Correspondence regarding this well should be addressed to S. G. Sanderson, Manager of Production
Address Box 661, Tulsa, Oklahoma


STATE OF Kansas, COUNTY OF Rice, ss.

H. H. Wright (employee of owner) or (owner or operator) of the above-described well, being first duly sworn on oath, says: That I have knowledge of the facts, statements, and matters herein contained and the log of the above-described well as filed and that the same are true and correct. So help me God.

(Signature) *H. H. Wright*
Box 544, Chase, Kansas (Address)

SUBSCRIBED AND SWORN TO before me this 9th day of August, 1949

My commission expires April 14, 1952 *M. M. Council* Notary Public.

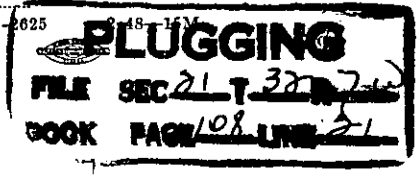

15-077-00207-00-00

WELL NO. **1** LEASE **Lloyd E. Dent Plugging** COMPANY **Gulf Oil Corporation** A.F.E. **2039**
 DATE—DRILLING BEGAN **6-27-49** WELL COMPLETED **8-4-49** FIRST PRODUCTION **- - - -**
 SAND RECORD **Arbuckle 4916' - 5050'** TOTAL DEPTH **5050'**

INITIAL PRODUCTION **Dry Hole - Plugged and Abandoned**

CASING RECORD

SIZE	WEIGHT	THD.	CLASS	MAKE	SET AT DEPTH	SACKS CEMENT	LBS. CAL. CHLO.	PULLED	LEFT IN
13-3/8"	46	CS	A	*	1210'	1300			1210'

Approximately 562' and 648' 85

S- 21 T- 320 R- 74

HA					0
HA					
HA					
Harper					
County					

ELEVATION— **1403'**

FORMATION RECORD:

	From	To
Surface hole	0'	140'
Surface hole 12 1/2"		295
Shale and shells		1050
Shale, shells and salt		1095
Shale and salt		1200
Anhydrite		1213
Shale and lime		1495
Lime and shale		1595
Shale and lime		1805
Lime		1960
Lime and shale		2040
Shale		2800
Lime and shale		2975
Shale		3260
Lime and shale		3590
Lime and sand		3675
Sand and shale		3745
Shale		3865
Lime		3970
Lime and shale		4080
Lime		4130
Lime and shale		4230
Lime		4260
Lime and shale		4285
Lime		4330
Lime and shale		4413
Lime and chert		4540
Lime		4645
Lime and shale		4769
Lime, shale and sand		4775
Sand		4780
Sand and lime		4820
Sand and shale		4835
Shale and sand		4860
Sand and shale		4920
Lime		5050
TOTAL DEPTH		

MD:KL

8-17-49

PLUGGING
 FILE NO. 21 T 320 74
 BOOK PAGE 10 & LINE 21

WELL NO. 7

LEASE

COMPANY

A.F.E.

DATE--DRILLING BEGAN

WELL COMPLETED

FIRST PRODUCTION

BAND RECORD

TOTAL DEPTH

INITIAL PRODUCTION

CASING RECORD

SIZE	WEIGHT	THD.	CLAS.	MAKE	DEPTH	SET AT	REMARKS	DATE	PULLED	LEFT IN

2-- T-- R--

ELEVATION--