

WELL PLUGGING RECORD

Give All Information Completely
Make Required Affidavit
Mail or Deliver Report to:
Conservation Division
State Corporation Commission
800 Biting Building
Wichita, Kansas

Happer County, Sec. 20 Twp. 32 Rge. 7 (E) W (W)

Location as "NE/CNW/SW" or footage from lines SE, SE, SW

Lease Owner Schafer Drilling Co.

Lease Name Barber Well No. B #1

Office Address Box 350, Pratt, Kansas

Character of Well (completed as Oil, Gas or Dry Hole) Dry Hole

Date well completed 11-29 19 54

Application for plugging filed 11-29 19 54

Application for plugging approved 11-29 19 54


Plugging commenced 11-29 19 54

Plugging completed 11-29 19 54

Reason for abandonment of well or producing formation Dry

If a producing well is abandoned, date of last production _____ 19 _____

Was permission obtained from the Conservation Division or its agents before plugging was commenced? yes

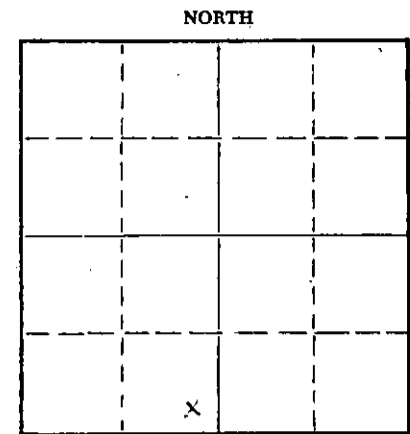

Locate well correctly on above Section Plat

Name of Conservation Agent who supervised plugging of this well Ruel Durkee

Producing formation _____ Depth to top _____ Bottom _____ Total Depth of Well 5010 Feet

Show depth and thickness of all water, oil and gas formations.

OIL, GAS OR WATER RECORDS

CASING RECORD

FORMATION	CONTENT	FROM	TO	SIZE	PUT IN	PULLED OUT
				8 5/8"	238	None

Describe in detail the manner in which the well was plugged, indicating where the mud fluid was placed and the method or methods used in introducing it into the hole. If cement or other plugs were used, state the character of same and depth placed, from _____ feet to _____ feet for each plug set.

Set plug at 230 feet and poured 15 sacks of cement through the drill pipe on top of the plug. Top plug was set at 20 feet with 5 sacks of cement.

11-30-1954

Name of Plugging Contractor Schafer Drilling Co.
Address Box 350, Pratt, Kansas

STATE OF Kansas, COUNTY OF Pratt, ss.

J. E. Selby (employee of owner) or (owner) of the above-described well, being first duly sworn on oath, says: That I have knowledge of the facts, statements, and matters herein contained and the log of the above-described well as filed and that the same are true and correct. So help me God.

(Signature) J. E. Selby
Pratt, Kansas (Address)

SUBSCRIBED AND SWORN to before me this 29th day of November, 1954
Maudie B. Mc Bride

My commission expires 6-30-55 Notary Public.

PLUGGING
FILE SEC 20 T 32 R 24
BOOK PAGE 0 LINE 34

15-077-00147-00-00

DRILLER'S LOG -----BARBER "B" #1-----HARPER COUNTY, KANSAS

0-50	Sand & Red Bed
50-1176	Shale and Shells
1176-1196	Lime and Shale
1196-1220	Shale and Shells
1220-1240	Shale and Anhydrite
1240-1560	Shale and Shells
1560-1970	Lime and Shale
1970-2825	Shale and Shells
2825-2913	Shale and Lime
2913-2965	Shale and Shells
2965-3180	Lime and Shale
3180-3370	Shale and Shells
3370-3450	Lime and Shale
3450-3650	Shale and Shells
3650-3735	Shale, Lime and Shells
3735-3835	Shale
3835-3868	Shale and Shells
3868-3930	Lime
3930-3965	Lime and Shale
3965-4470	Lime
4470-4565	Lime and Chert
4565-4678	Lime
4678-4784	Lime and Shale
4784-4845	Lime
4845-4878	Sand and Shale
4878-4883	Lime
4883-4892	Hard Sand
4892-4910	Sand
4910-4969	Shale and Sand
4969-5010	Lime and Shale
5010	TOTAL DEPTH

I certify that the above drillers log is true and correct as being taken directly from the daily drilling reports of the Barber "B" #1.

J. E. Selby
J. E. Selby
SCHAFFER DRILLING CO.

STATE OF KANSAS: COUNTY OF PRATT: SS:

Subscribed and sworn to before me this 29th day of November, 1954.

PLUGGING
FILE SEC 20 T 32 R 24
BOOK PAGE 80 LINE 34

Maudie B McBride
Notary Public

My commission expires 6-30-55

NOV 30 1954
11-30-1954