

WELL PLUGGING RECORD

Give All Information Completely
Make Required Affidavit
Mail or Deliver Report to:
Conservation Division
State Corporation Commission
211 No. Broadway
Wichita, Kansas

Harper County, Sec. 19 Twp. 38S Rge. 7W (E) (W)

Location as "NE/CNW&SW¼" or footage from lines NW SE NW

Lease Owner The Superior Oil Company

Lease Name Driskell Well No. # 1

Office Address Box 200 Casper, Wyoming

Character of Well (completed as Oil, Gas or Dry Hole)

Date well completed 19

Application for plugging filed yes 19

Application for plugging approved yes 19


Plugging commenced 9-16-61 19

Plugging completed 9-21-61 19

Reason for abandonment of well or producing formation

If a producing well is abandoned, date of last production 19

Was permission obtained from the Conservation Division or its agents before plugging was commenced? yes

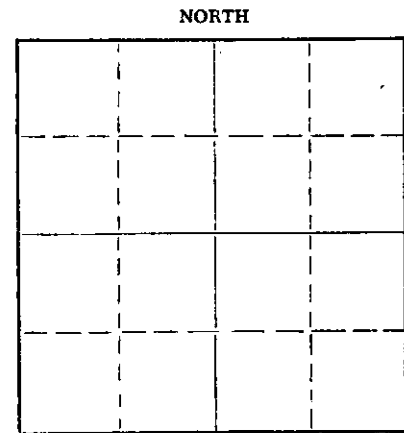

Locate well correctly on above Section Plat

Name of Conservation Agent who supervised plugging of this well Fred Hampel

Producing formation Depth to top Bottom Total Depth of Well 1500' Feet

Show depth and thickness of all water, oil and gas formations.

OIL, GAS OR WATER RECORDS

CASING RECORD

FORMATION	CONTENT	FROM	TO	SIZE	PUT IN	PULLED OUT
				5 1/2"		3,468'

Describe in detail the manner in which the well was plugged, indicating where the mud fluid was placed and the method or methods used in introducing it into the hole. If cement or other plugs were used, state the character of same and depth placed, from feet to feet for each plug set.

Ran bailer and found cement at 3480'.

Worked & shot 5 1/2" casing free at 3468'. Built rack and slide. Pulled and layed down casing.

Plugged well: Mudded up to 300'. Set 10' rock bridge at 300'. Dumped 20 sacks cement. Mudded up to 45'. Set 10' rock bridge at 45'. Capped the well with 10 sacks cement.

STATE CORPORATION COMMISSION

NOV 6 1961

CONSERVATION DIVISION
Wichita, Kansas

(If additional description is necessary, use BACK of this sheet)

Name of Plugging Contractor Forbes Casing Pulling, Inc.

Address Box 221 Great Bend, Kansas

11-06-1961

STATE OF Kansas, COUNTY OF Barton, ss.

J. O. Forbes (employee of owner) or (owner or operator) of the above-described well, being first duly sworn on oath, says: That I have knowledge of the facts, statements, and matters herein contained and the log of the above-described well as filed and that the same are true and correct. So help me God.

(Signature) J. O. Forbes
Great Bend, Kansas
(Address)

SUBSCRIBED AND SWORN TO before me this 25th day of September, 1961

Kayann Jenkins
Notary Public

My commission expires December 8th, 1963

15-077-10161-00-00

ROTARY DRILLING LOG

OPERATOR: The Superior Oil Company
LRISKELL UNIT NO. 1
NW SE NW Sec. 19-32-7W,
Harper County, Kansas

CONTRACTOR: Capitt Drilling, Inc.
COMM: 4-1-61
COMP: 4-12-61 (Reached TD)
COMP: 4-14-61 (Drilling In)

Surface Casing: Set 309.98' of 8-5/8"
surface casing at 307'
cemented w/250 sz. Com.,
w/2% C.C.

Formations:

Sand & Red Bed	120'
Red Rock	307'
Red Bed	330'
Red Rock	960'
Shale & Shells	1475'
Shale & Lime	1740'
Lime	1998'
Lime & Shale	3990'
Lime	4500'
Rotary Total Depth	4500'

Set 5-1/2" casing at 4500' cemented
with 200 Cu. Ft. #1 Pozmix.

We certify the above log is true and
correct to the best of our knowledge
and belief.

CAPITT DRILLING, INC.

R. R. McNicol

R. R. McNicol

11-06-1961