


15-077-20284-00-00

STATE OF KANSAS  
STATE CORPORATION COMMISSION  
Give All Information Completely  
Make Required Affidavit  
Mail or Deliver Report to:  
Conservation Division  
State Corporation Commission  
212 No. Market  
Wichita, Kansas 67202

WELL PLUGGING RECORD

Harper County, Sec. 18 Twp. 32S Rge. 7 (E) W(W)  
Location as "NE/CNW/SW" or footage from lines S/2 SE NW  
Lease Owner McCoy Petroleum Company  
Lease Name Yoder Well No. 1  
Office Address 502 Union Center Wichita, Kansas 67202  
Character of Well (completed as Oil, Gas or Dry Hole) Oil Well  
Date well completed 12-3-74 19  
Application for plugging filed 7-22-75 19  
Application for plugging approved 7-24-75 19  
Plugging commenced 7-28-75 19  
Plugging completed 8-4-75 19  
Reason for abandonment of well or producing formation Non-commercial

If a producing well is abandoned, date of last production June 19 75  
Was permission obtained from the Conservation Division or its agents before plugging was commenced? Yes

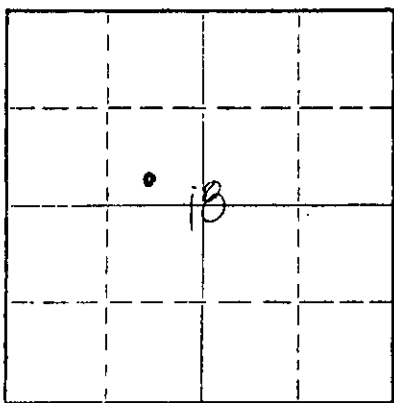

Locate well correctly on above Section Plat

Name of Conservation Agent who supervised plugging of this well Russell Bieberstein  
Producing formation Kansas City Depth to top 3878 Bottom 4092 Total Depth of Well 4447 Feet  
Show depth and thickness of all water, oil and gas formations.

OIL, GAS OR WATER RECORDS

CASING RECORD

FORMATION	CONTENT	FROM	TO	SIZE	PUT IN	PULLED OUT
				8-5/8"	243'	None
				5-1/2"	4444'	3584'
Kansas City	Oil & Water	4023'	4026'			

Describe in detail the manner in which the well was plugged, indicating where the mud fluid was placed and the method or methods used in introducing it into the hole. If cement or other plugs were used, state the character of same and depth placed, from \_\_\_\_\_ feet to \_\_\_\_\_ feet for each plug set.

Sand from 4447' to 4010'.  
5 sx. of cement from 4010' to 3980'.  
Ripped at 3680' and 3584'.  
Wood-bridge at 200'.

Rock from 200 to 190'.  
3 yards of ready mix to top.

RECEIVED  
STATE CORPORATION COMMISSION

FEB 2 1976

CONSERVATION DIVISION  
Wichita, Kansas

02-02-1976

(If additional description is necessary, use BACK of this sheet)  
Name of Plugging Contractor Clarke Corporation  
Address Box 187, Medicine Lodge, Kansas 67104

STATE OF Kansas, COUNTY OF Sedgwick, ss.  
John Roger McCoy (employee or owner) or (owner or operator) of the above-described

well, being first duly sworn on oath, says: That I have knowledge of the facts, statements, and matters herein contained and the log of the above-described well as filed and that the same are true and correct. So help me God. MCCOY PETROLEUM COMPANY

(Signature) John Roger McCoy  
John Roger McCoy  
502 Union Center, Wichita, Kansas 67202  
(Address)

SUBSCRIBED AND SWORN TO before me this 11th day of August, 19 75

My commission expires February 20, 1978

Christina Louise Duncan  
Christina Louise Duncan

Notary Public  
Christina Louise Duncan  
NOTARY PUBLIC  
SEDGWICK COUNTY, KANSAS  
MY COMM. EXP. FEB. 20, 1978

WELL LOG  
Yoder #1  
SE NW 18-s2S-7W  
Harper County, Kansas

15-077-20284-00-00

Name of Operator: McCoy Petroleum Company  
502 Union Center Building  
Wichita, Kansas 67202

Date Completed: December 3, 1974

FROM	TO	
0	860	Red bed and shale
860	3648	Shale and lime
3648	3708	Stal. sand
3708	4185	Lime and shale
4185	4447	Lime
4447		Total Depth

RECEIVED  
STATE CORPORATION COMMISSION  
07-24-1975  
JUL 24 1975

STATE OF KANSAS

CONSERVATION DIVISION  
Wichita, Kansas

COUNTY OF BARTON ss

Gary L. Hawk, Secretary of Sweetman Drilling, Inc., being first duly sworn on oath says: That I have knowledge of the facts, statements and matters herein contained and the log of the above described well as filed and that the same are true and correct.

*Gary L. Hawk*  
\_\_\_\_\_  
Gary L. Hawk

Subscribed and sworn before me this 10th day of December, 1974.

*Mary Ann Schwaborn*  
\_\_\_\_\_  
Notary Public Barton County

My Commission Expires 7-10-77

