

15-077-20125-00-00

STATE OF KANSAS
STATE CORPORATION COMMISSION


Give All Information Completely
Make Required Affidavit
Mail or Deliver Report to
Conservation Division
State Corporation Commission

P. O. Box 17027
Wichita, Kansas 67217
NORTH

WELL PLUGGING RECORD

Harper County, Sec. 16 Twp 32S Rge. (E) 7 (W)

Location as "NE/CNW/SE/SW" or footage from lines: C-SE of NW
Lease Owner: GERAL E. BORELLI
Lease Name: "Muir" Well No.
Office Address: P.O. Box 338 Kingfisher, Okla. 73750
Character of Well (completed as Oil, Gas or Dry Hole): dry hole
Date well completed: August 26 19 71
Application for plugging filed: February 13 19 74
Application for plugging approved: February 15 19 74
Plugging commenced: February 16 19 74
Plugging completed: February 17 19 74
Reason for abandonment of well or producing formation: wet-to much water

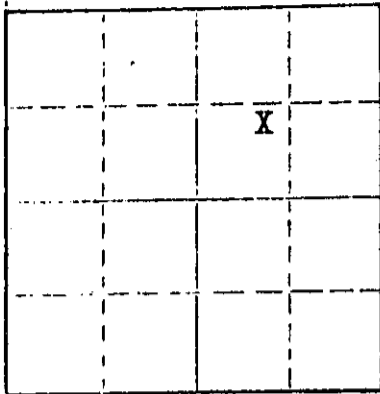

Locate well correctly on above
Section Plot

If a producing well is abandoned, date of last production: 19
Was permission obtained from the Conservation Division or its agents before plugging was commenced? yes

Name of Conservation Agent who supervised plugging of this well: Russell Biberstein
Producing formation: Depth to top: Bottom: Total Depth of Well: 4,755 Feet
Show depth and thickness of all water, oil and gas formations.

OIL, GAS OR WATER RECORDS

CASING RECORD

FORMATION	CONTENT	FROM	TO	SIZE	PUT IN	PULLED OUT
Surface				8-5/8	252	0
Mississippi	salt water	4,396	4,420	4-1/2	4,522	3,350

Describe in detail the manner in which the well was plugged, indicating where the mud fluid was placed and the method or methods used in introducing it into the hole. If cement or other plugs were used, state the character of same and depth placed, from feet to feet for each plug set.

Pumped bottom plug 30 sks. cement 3,900' to 4,150'--Pumped top plug 100 sks. cement 4' below surface to 500'--

RECEIVED
STATE CORPORATION COMMISSION

MAR 4 1974

CONSERVATION DIVISION
Wichita, Kansas

03-04-1974

(If additional description is necessary, use BACK of this sheet)

Name of Plugging Contractor: Crescent Well Service
Address: P.O. Box 644 Hennessey, Oklahoma 73742

STATE OF _____ COUNTY OF _____, ss.
(employee of owner) or (owner or operator) of the above-described well, being first duly sworn on oath, says: That I have knowledge of the facts, statements, and matters herein contained and the log of the above-described well as filed and that the same are true and correct. So help me God.

(Signature) Leland Biberstein

SUBSCRIBED AND SWORN TO before me this 1st day of March, 19 74

(Address) Rhoda Bailey
Notary Public.

My commission expires 4-19-75