

15-077-20191-00-00

RECEIVED  
STATE CORPORATION COMMISSION

STATE OF KANSAS  
STATE CORPORATION COMMISSION


MAY 24 1973 05-24-1973

Form CP-4

CONSERVATION DIVISION WELL PLUGGING RECORD  
Wichita, Kansas

Give All Information Completely  
Make Required Affidavit  
Mail or Deliver Report to:  
Conservation Division  
State Corporation Commission  
P. O. Box 17027  
Wichita, Kansas 67217  
NORTH

Harper County, Sec. 16 Twp 32S3 Rge. 7W (E) (W)  
Location as "NE/CNW/SW" or footage from lines C SW/4 NW/4 SW/4  
Lease Owner Gerald E. Borelli  
Lease Name Headberg Well No. 1  
Office Address Box 338, Kingfisher, Oklahoma  
Character of Well (completed as Oil, Gas or Dry Hole) Dry Hole  
Date well completed 5/17 19 73  
Application for plugging filed 5/17 19 73  
Application for plugging approved 5/17 19 73  
Plugging commenced 5/17 19 73  
Plugging completed 5/17 19 73  
Reason for abandonment of well or producing formation No shows.

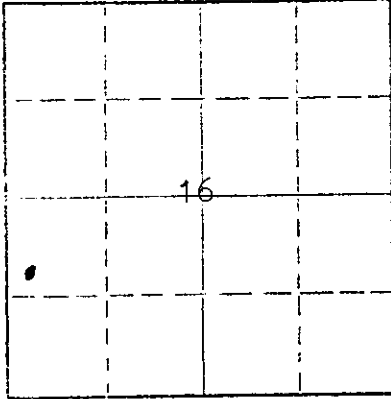

Locate well correctly on above  
Section Plat

If a producing well is abandoned, date of last production none 19  
Was permission obtained from the Conservation Division or its agents before plugging was commenced? yes

Name of Conservation Agent who supervised plugging of this well G. Russell Biberstein  
Producing formation none Depth to top Bottom Total Depth of Well 4792 Feet  
Show depth and thickness of all water, oil and gas formations.

OIL, GAS OR WATER RECORDS

CASING RECORD

FORMATION	CONTENT	FROM	TO	SIZE	PUT IN	PULLED OUT
Surface pipe		Ground	257'	85/8	257'	None
No Production	Casing	Run				

Describe in detail the manner in which the well was plugged, indicating where the mud fluid was placed and the method or methods used in introducing it into the hole. If cement or other plugs were used, state the character of same and depth placed, from feet to feet for each plug set.

Drilling Contractor, after reaching to a depth, came out of hole laying down drill pipe. Last mud check was 9.4# weight, 42 viscosity, 8 water loss. Contractor set 2 cement plugs, one at bottom of surface pipe with 40 sks, and a top plug at 40' with 10 sks. and 2 sks in rat hole.

(If additional description is necessary, use BACK of this sheet)

Name of Plugging Contractor Thomas Drilling Company  
Address Duncan, Okla.

STATE OF Oklahoma COUNTY OF Kingfisher ss.  
Gerald E. Borelli (employee of owner) or (owner or operator) of the above-described well, being first duly sworn on oath, says: That I have knowledge of the facts, statements, and matters herein contained and the log of the above-described well as filed and that the same are true and correct. So help me God.

(Signature) *Gerald Borelli*  
P. O. Box 338 - Kingfisher, Ok. 73750  
(Address)

SUBSCRIBED AND SWORN TO before me this 22nd day of May, 19 73

*Evelyn West*  
Evelyn West Notary Public.

My commission expires April 26, 1975