


WELL PLUGGING RECORD

Give All Information Completely
Make Required Affidavit
Mail or Deliver Report to:
Conservation Division
State Corporation Commission
211 No. Broadway
Wichita, Kansas

HARPER County, Sec. 32S Twp. 7W Rge. (E) (W)
Location as "NE/CNW/SW" or footage from lines C NE SW SW
Lease Owner WALTERS DRILLING CO.
Lease Name WASHBON Well No. 1
Office Address 510 Orpheum Building, Wichita, Kansas
Character of Well (completed as Oil, Gas or Dry Hole) D & A
Date well completed September 12th, 1960 19
Application for plugging filed September 12th, 1960 19
Application for plugging approved September 12th, 1960 19
Plugging commenced September 12th, 1960 19
Plugging completed September 12th, 1960 19
Reason for abandonment of well or producing formation

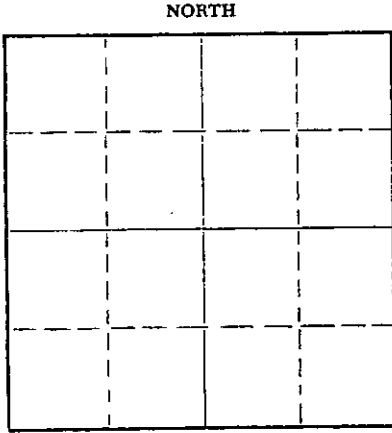

Locate well correctly on above
Section Plat

If a producing well is abandoned, date of last production 19
Was permission obtained from the Conservation Division or its agents before plugging was commenced? YES

Name of Conservation Agent who supervised plugging of this well ?
Producing formation Depth to top Bottom Total Depth of Well 4799' Feet
Show depth and thickness of all water, oil and gas formations.

OIL, GAS OR WATER RECORDS

CASING RECORD

| FORMATION | CONTENT | FROM | TO | SIZE | PUT IN | PULLED OUT |
|-----------|---------|------|----|--------|--------|------------|
| | | | | 8-5/8" | 206' | ---- |
| | | | | | | |
| | | | | | | |
Describe in detail the manner in which the well was plugged, indicating where the mud fluid was placed and the method or methods used in introducing it into the hole. If cement or other plugs were used, state the character of same and depth placed, from feet to feet for each plug set.

Filled with heavy mud to 200' set plug
with 15 sx cement. Filled to 35' with
heavy mud, set solid bridge with 8 sx
to base of cellar.

Job complete 0215/9-12-60

RECEIVED
STATE CORPORATION COMMISSION
09-22-1960
SEP 22 1960

CONSERVATION DIVISION
Wichita, Kansas

(If additional description is necessary, use BACK of this sheet)

Name of Plugging Contractor WALTERS DRILLING CO.
Address 510 Orpheum Building, Wichita, Kansas

STATE OF KANSAS, COUNTY OF SEDGWICK, ss.
R. L. Abel (employee of owner) or (owner or operator) of the above-described

well, being first duly sworn on oath, says: That I have knowledge of the facts, statements, and matters herein contained and the log of the above-described well as filed and that the same are true and correct. So help me God.

(Signature) R. L. Abel of WALTERS DRILLING CO.
510 Orpheum Building, Wichita, Kansas
(Address)

SUBSCRIBED AND SWORN TO before me this 21 day of September, 1960

Patrida M. Edwards, Notary Public.

My commission expires August 11th, 1962.













DRILLER'S LOG

| | | | |
|-------------|---|-------------|---|
| OPERATOR: | WALTERS DRILLING CO. 510 Orpheum Building Wichita 2, Kansas | FARM NAME: | #1 WASHBON |
| CONTRACTOR: | WALTERS DRILLING CO. 510 Orpheum Building Wichita 2, Kansas | LOCATION: | NE SW SW Sec. 15-32S-7W Harper Co, Kansas |
| COMMENCED: | August 30th, 1960 | ELEVATION: | 1413' KB 1411- DF 1408' GL |
| COMPLETED: | September 12th, 1960 | PRODUCTION: | D & A |
| CASING: | 8-5/8" @ 206' (175 sx cmt) | | |
| R.T.D. | 4799' | | |

FORMATION RECORD

Depths shown indicate bottom of formations

| | |
|-------------------------------------|-------|
| Surface material, Shale & Red Shale | 207 |
| Red Bed, Shale & Shells | 800 |
| Shale & Shells | 1150 |
| Lime & Shale | 3090 |
| Sand & Shale | 3245 |
| Lime & Shale | 3572 |
| Sand & Shale | 3690 |
| Lime & Shale | 3849 |
| Lime | 4040 |
| Lime & Shale | 4392 |
| Mississippian | 4504 |
| Lime & Chert | 4606 |
| Lime | 4649 |
| Shale & Lime | 4685 |
| Shale | 4755 |
| Shale & Lime | 4781 |
| Sand | 4799 |
| R.T.D. | 4799' |

CERTIFICATION

RECEIVED
STATE CORPORATION COMMISSION
09-22-1960
SEP 22 1960

CONSERVATION DIVISION
Wichita, Kansas

STATE OF KANSAS)
COUNTY OF SEDGWICK) SS:

I, R. L. Abel, of WALTERS DRILLING CO., upon oath do hereby state that the foregoing is a true and correct copy of the Driller's Log of the above named well.

R. L. Abel

R. L. Abel

Subscribed and sworn to before me on this 21st day of September, 1960.
My commission expires: August 11th, 1962.

Patticia M. Edwards
Patticia M. Edwards, Notary Public