

See

15-077-10126-00-00

STATE OF KANSAS
STATE CORPORATION COMMISSION

Give All Information Completely
Make Required Affidavit
Mail or Deliver Report to:
Conservation Division
State Corporation Commission
212 North Market, Insurance Bldg.
Wichita, Kansas

WELL PLUGGING RECORD

Harper County, Sec. 14 Twp. 3 2 Rge. (E) 7 (W)

Location as "NE/CNW&SW4" or footage from lines NE/4 NE/4 NE/4

Lease Owner Skelly Oil Company

Lease Name Julia Bebermeyer Well No. 1

Office Address Box 1650, Tulsa, Oklahoma

Character of Well (completed as Oil, Gas or Dry Hole) Gas

Date well completed August 28, 19 58

Application for plugging filed September 15, 19 60

Application for plugging approved September 21, 19 60


Plugging commenced September 28, 19 60

Plugging completed September 30, 19 60

Reason for abandonment of well or producing formation Unable to produce against gathering line

If a producing well is abandoned, date of last production July 19 60

Was permission obtained from the Conservation Division or its agents before plugging was commenced? Yes

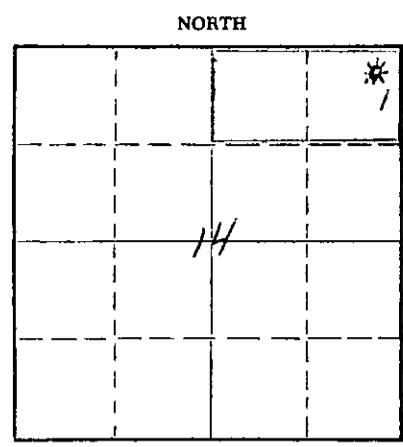

Locate well correctly on above Section Plat

Name of Conservation Agent who supervised plugging of this well Mr. Fred Hampel

Producing formation Mississippi Depth to top 4370 Bottom Total Depth of Well 4787 Feet

Show depth and thickness of all water, oil and gas formations. PB 4737'

OIL, GAS OR WATER RECORDS

CASING RECORD

FORMATION	CONTENT	FROM	TO	OD SIZE	PUT IN	PULLED OUT
Mississippi	Oil, Gas	4366'	4374'	8-5/8"	600' 0"	None
Viola	Oil, Gas	4720'	4728'	5-1/2"	4824' 6"	3506' 0"
Simpson	Gas	4729'	4732'			

Describe in detail the manner in which the well was plugged, indicating where the mud fluid was placed and the method or methods used in introducing it into the hole. If cement or other plugs were used, state the character of same and depth placed, from feet to feet for each plug set.

- Sand 4397' to 4350'
- 4 sacks of cement 4350' to 4318'
- Mud 4318' to 400'
- Crushed rock 400' to 390'
- 20 sacks of cement 390' to 330'
- Mud 330' to 35'
- Crushed rock 35' to 30'
- 10 sacks of cement 30' to 6'
- Surface soil 6' to Surface

RECEIVED
STATE CORPORATION COMMISSION
11-30-1960
NOV 30 1960

CONSERVATION DIVISION
Wichita, Kansas

(If additional description is necessary, use BACK of this sheet)

Name of Plugging Contractor Ace Pipe Pulling Company
Address Box 304, Great Bend, Kansas

STATE OF Kansas, COUNTY OF Reno, ss.
H. E. Wamsley (employee of owner) or (Notary Public)

well, being first duly sworn on oath, says: That I have knowledge of the facts, statements, and matters herein contained and the log of the above-described well as filed and that the same are true and correct. So help me God.

(Signature) [Signature]
Box 391, Hutchinson, Kansas
(Address)

SUBSCRIBED AND SWORN to before me this 28th day of November, 19 60

My commission expires April 7, 1963

[Signature]
Notary Public.