


STATE OF KANSAS
STATE CORPORATION COMMISSION

WELL PLUGGING RECORD

Give All Information Completely
Make Required Affidavit
Mail or Deliver Report to
Conservation Division
State Corporation Comm.
245 North Water
Wichita, KS 67202

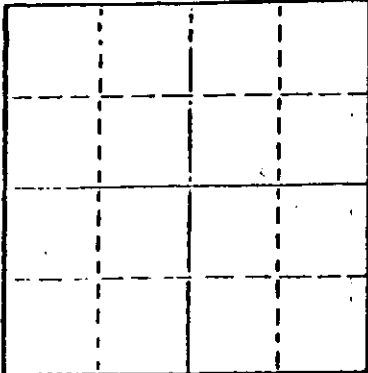

Locate well correctly on above
Section Plot

Ness County. Sec. 19 Twp. 16 Rge. 26 E/W
Location as "NE/CNW $\frac{1}{4}$ SW $\frac{1}{4}$ " or footage from lines
NW NW SW

Lease Owner Thundebird Drilling, Inc.
Lease Name Horchem G#1 Well No. _____
Office Address Ellinwood, Kansas 67566
Character of Well (Completed as Oil, Gas or Dry Hole) _____

Date Well completed 19____
Application for plugging filed 19____
Application for plugging approved 19____
Plugging commenced 11/10/78 19____
Plugging completed 11/29/78 19____
Reason for abandonment of well or producing formation
depleted.

If a producing well is abandoned, date of last production
19____

Was permission obtained from the Conservation Division or
its agents before plugging was commenced? yes

Name of Conservation Agent who supervised plugging of this well Massey
Producing formation _____ Depth to top _____ Bottom _____ Total Depth of Well 4554
Show depth and thickness of all water, oil and gas formations.

OIL, GAS OR WATER RECORDS

CASING RECORD

FORMATION	CONTENT	FROM	TO	SIZE	PUT IN	PULLED OUT
				8-5/8	330	none
				5 1/2"	4544	899'

Describe in detail the manner in which the well was plugged, indicating where the mud fluid
was placed and the method or methods used in introducing it into the hold. If cement or other
plugs were used, state the character of same and depth placed, from _____ feet to
_____ feet for each plug set.

Sanded to 4300' and ran 4 sacks cement. Loaded hole, checked hole, went to
3525' with weight, shot pipe at 3092', 2592', 2000', 1718', 1508', 1322',
1221', 1129', 1029', 899', pulled 26 joints. Pumped 25 sacks gel, 1 sack hulls,
8-5/8 plug and 120 sacks cement.

PLUGGING COMPLETE.

RECEIVED
STATE CORPORATION COMMISSION

DEC - 8 19/78
12-8-78

(If additional description is necessary, use BACK of this sheet.)


Name of Plugging Contractor KELSO CASING PULLING
CHASE, KANSAS

STATE OF KANSAS COUNTY OF RICE, ss.
R. DARRELL KELSO (employee of owner) or (owner or operator)
of the above-described well, being first duly sworn on oath, says: That I have knowledge of
the facts, statements, and matters herein contained and the log of the above-described well
as filed and that the same are true and correct. So help me God.

(Signature) R. Darrell Kelso
CHASE, KANSAS
(Address)

SUBSCRIBED AND SWORN TO before me this 7th day of December, 19 78

My commission expires _____

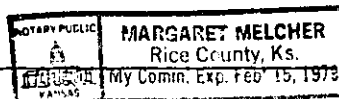

Margaret Melcher
Notary Public.