

Give All Information Completely
Make Required Affidavit
Mail or Deliver Report to:
Conservation Division
State Corporation Commission
211 No. Broadway
Wichita, Kansas

WELL PLUGGING RECORD

Ness County. Sec. 19 Twp. 16S Rge. (E) 26(W)

Location as "NE/CNW/SW" or footage from lines C SW SE

Lease Owner Kimbark Exploration Company

Lease Name Horchem Well No. 1

Office Address 201 University Blvd. Denver 6, Colorado

Character of Well (completed as Oil, Gas or Dry Hole) D&A

Date well completed 5/10 1964

Application for plugging filed 5/10 1964

Application for plugging approved 5/10 1964


Plugging commenced 5/10 1964

Plugging completed 5/10 1964

Reason for abandonment of well or producing formation _____

If a producing well is abandoned, date of last production _____ 19____

Was permission obtained from the Conservation Division or its agents before plugging was commenced? yes

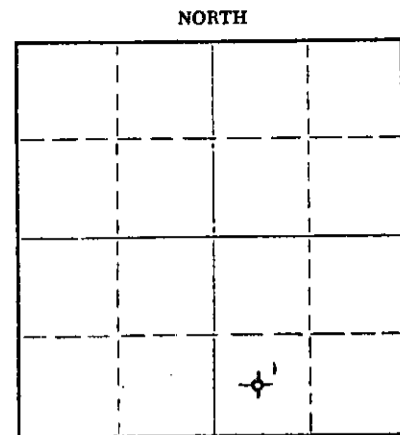

Name of Conservation Agent who supervised plugging of this well _____

Producing formation _____ Depth to top _____ Bottom _____ Total Depth of Well 4690 Feet

Show depth and thickness of all water, oil and gas formations.

OIL, GAS OR WATER RECORDS

CASING RECORD

FORMATION	CONTENT	FROM	TO	SIZE	PUT IN	PULLED OUT
		0	250	8 5/8"	240'	0

Describe in detail the manner in which the well was plugged, indicating where the mud fluid was placed and the method or methods used in introducing it into the hole. If cement or other plugs were used, state the character of same and depth placed, from _____ feet to _____ feet for each plug set.

plug @ 600 w/20 sacks cement
@ 250 w/20 sacks cement

RECEIVED
STATE CORPORATION COMMISSION

MAY 20 1964
520-64
CONSERVATION DIVISION
Wichita, Kansas

(If additional description is necessary, use BACK of this sheet)

Name of Plugging Contractor Kimbark Exploration Company

Address 201 University Blvd. Denver 6, Colorado

STATE OF Colorado COUNTY OF Denver, ss.

W. K. Arbuckle President (employee of owner) or (owner or operator) of the above-described well, being first duly sworn on oath, says: That I have knowledge of the facts, statements, and matters herein contained and the log of the above-described well as filed and that the same are true and correct. So help me God.

(Signature) W. K. Arbuckle

201 University Blvd. Denver 6, Colorado
(Address)

SUBSCRIBED AND SWORN to before me this 18 th day of May, 19 64

Barbara J. Dodson
Notary Public.

My commission expires Jan. 28, 1968

KIMBARK EXPLORATION COMPANY

201 UNIVERSITY BOULEVARD
DENVER, COLORADO 80206
388-4021
AREA CODE 303

15-135-60349 0000

1 Horchem C SW SE Sec. 19-16S-26W Ness Co., Kansas

Driller's Log

0-256 Sand & shale

256-1530 Sand, shale & anhydrite

1530-2319 Sand, shale & anhydrite

2319-2771 Shale & lime

2771-3073 Lime & shale

3073-3364 Shale & lime

3364-3700 Shale & lime

3700-3969 Lime & shale

3969-4119 Lime

4119-4197 Lime

4197-4335 Lime

4335-4500 Lime

4500-4580 Lime

4580-4610 Lime & chert

4610-4690 Lime

RECEIVED
STATE CORPORATION COMMISSION

MAY 20 1964

CONSERVATION DIVISION
Wichita, Kansas